


103 -

30974

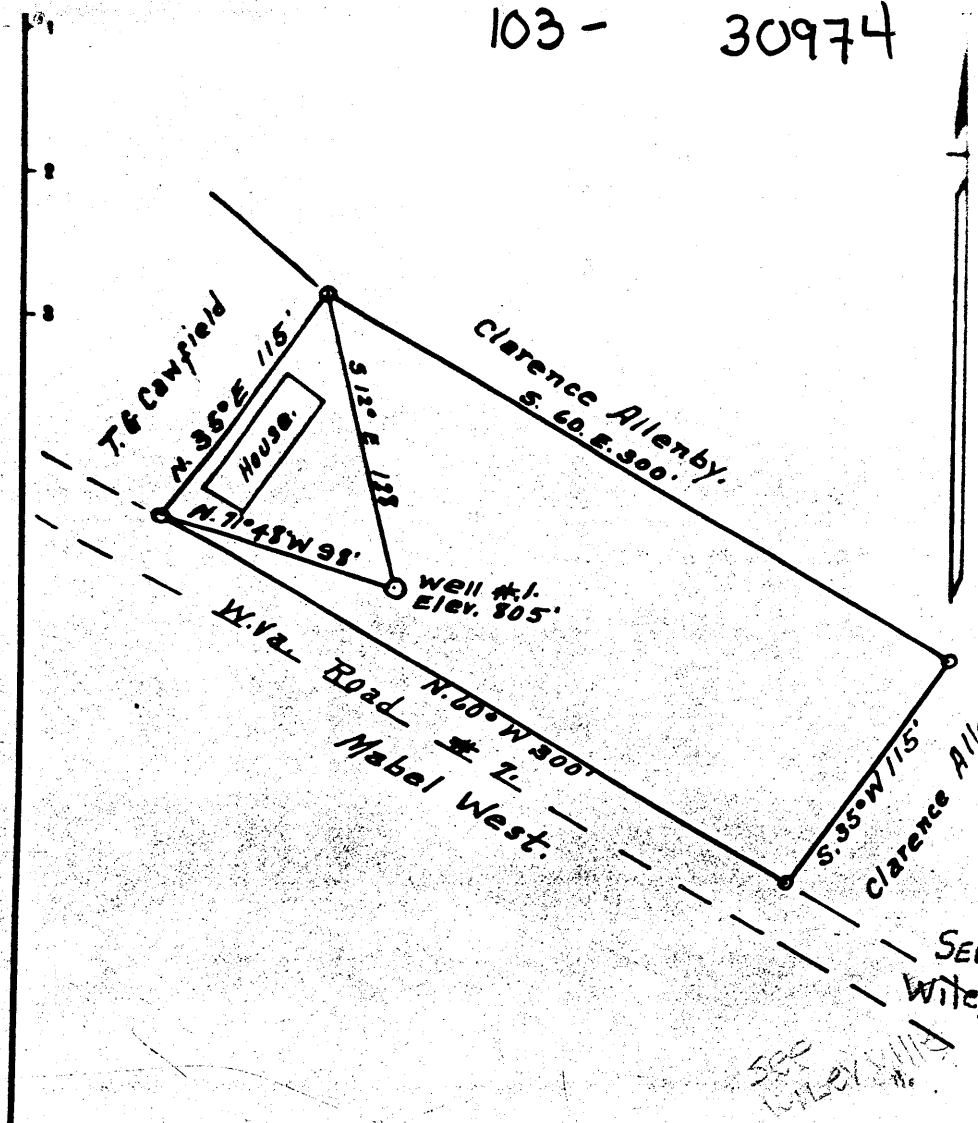

SEE  
Wileyville  
Quad.

SEE  
WILEYVILLE  
No.

Coal & Surface - Robert D. Wileyville W

New Location   
 Drill Deeper   
 Abandonment

Company Valley Steel Products Co  
 Address St. Louis, Mo.  
 Farm Ebenezer Daken  
 Tract 1 Acres Lot Lease No. \_\_\_\_\_  
 Well (Farm) No. 1 Serial No. \_\_\_\_\_  
 Elevation (Spirit Level) 805'  
 Quadrangle Littleton  
 County Wetzel District Center

STATE OF WEST VIRGINIA  
 DEPARTMENT OF MINES  
 OIL AND GAS DIVISION  
 CHARLESTON

WELL LOCATION  
 FILE NO. WCT-974A

⬥ Denotes location of well on U.S. Geologic Map scale 1:250,000

# WELL RECORD

Oil or Gas Well \_\_\_\_\_

Name _____ Location _____ Date _____ Drilled by _____ Drilling Company _____ Drilling Date _____ Drilling Time _____ Drilling Depth _____ Drilling Method _____ Drilling Equipment _____ Drilling Fluid _____ Drilling Tools _____ Drilling Logs _____ Drilling Reports _____ Drilling Plans _____ Drilling Notes _____ Drilling Observations _____ Drilling Conclusions _____ Drilling Recommendations _____ Drilling Summary _____ Drilling Index _____ Drilling Glossary _____ Drilling Bibliography _____ Drilling References _____ Drilling Acknowledgments _____ Drilling Credits _____ Drilling Index _____ Drilling Glossary _____ Drilling Bibliography _____ Drilling References _____ Drilling Acknowledgments _____ Drilling Credits _____	<table border="1" style="width: 100%; border-collapse: collapse;"> <tr> <th style="width: 10%;">Depth</th> <th style="width: 10%;">Feet</th> <th style="width: 10%;">Meters</th> <th style="width: 10%;">Remarks</th> </tr> <tr> <td>100</td> <td>100</td> <td></td> <td></td> </tr> <tr> <td>1248</td> <td>1248</td> <td></td> <td></td> </tr> <tr> <td>1905</td> <td>1905</td> <td></td> <td></td> </tr> <tr> <td>2622</td> <td>2622</td> <td></td> <td></td> </tr> </table> <p>                     CASING CEMENTED _____ FEET _____ IN. _____ DIA.                      GOAL WAS ENCOUNTERED AT <u>12<sup>th</sup></u> FEET <u>747</u> INCHES                      _____ FEET _____ INCHES _____ FEET _____ INCHES                      _____ FEET _____ INCHES _____ FEET _____ INCHES                 </p>	Depth	Feet	Meters	Remarks	100	100			1248	1248			1905	1905			2622	2622		
Depth	Feet	Meters	Remarks																		
100	100																				
1248	1248																				
1905	1905																				
2622	2622																				

Description	Start	End	Feet	Meters	Oil or Gas or Water	Depth Found	Remarks
Top Soil			747	798			
St. Richard			1180	1200			
Shale			1248	1276			
Shale			1340	1754			
Shale			1835	1855			
Shale			1900	1969			
Shale			1969	2185			
Shale			2520	2530			
Carbon Gray			2769	2780			
Carbon			2791	2803	011 2795-2798		
Total Depth				2822			



