Latitude

Longitud

2.565 .20w

Topo Location

7.5' Loc.______ 15' Loc._____ (calc.)

Company Valley Steel Prods Co


Farm Ebenezer Dakan #2

7.5' Quad Wileyville

District Center

WELL LOCATION PLAT

County 103 Permit 30975

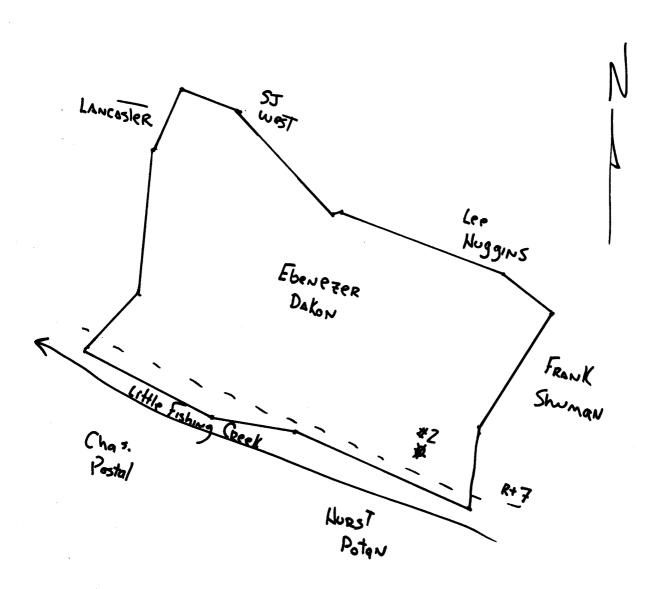



STATE OF WEST VIRGINIA DEPARTMENT OF MINES OIL AND GAS DIVISION

Ebeneser Or Robt, Daket

Company_

Address_

Well No._

Location (waters)_

District Conton

Drilling commenced_ Drilling completed____

Date Shot_

With_ Open Flow

The surface of tract is owned in fee by.

Mineral rights are owned by___

Farm_

1/N MELL I	WELL RECORD			Oil or Gas Well (KIND)		
Valley Steel Products Co.	Casing and Tubing	Used in Drilling	Left in Well	Packers		
neser Or Robt, Dekames	Size			Kind of Packer		
Elev.	16		•	Rind of Packer		
County Co	10			Size of		
Address	8¼ 6%		1210 1930	Depth set		
owned byAddress	5 3/16					
Ang. 4 1962	3 2		2000	Perf. top Perf. bottom		
From To	Liners Used	3		Perf. top Perf. bottom		
/10ths Water in Inch /10ths Merc. in Inch	CASING CEME	NTED	SIZE	No. Ft. Date		
Cu. Fthrs.	COAT WAS EN	IOOHINIMADE!		FEET 3 2 INCHES		

/10ths Merc. inInch				CASING CEMENTED SIZE No. Ft. Date				
Volume			Cu. Ft.				er	
Rock Pressure lbs. hrs. Oil bbls., 1st 24 hrs. Fresh water feet feet			COAL WAS ENCOUNTERED AT FEET INCHES					
			FEE	TINCHE	esfeet	FEET INCHES		
Salt water		feet	feet	FEE	TINCHI	esfeet	INCHES	
Formation	Color	Hard or Soft	Тор	Bottom	Oil, Gas or Water	Depth Found	Remarks	
					in president of the		•	
Pgh Coal		,	777	778			er er	
Lt. Danks	rđ		1210	1230			•	
Dig. *			1278	1306				
Selt.	·		1370	1785				
Beron			1865	1885				
Big ine			1930	1999		1		
" Injun			1999	2215		(// //		
50.Ft.		A	2550	2560				
Gordon 84	rey		2799	2810				
Cordon			2621	2833 041	2820			
Total Dep	th.			2852				
							· · · · · · · · · · · · · · · · · · ·	
		·						
		-						
					1		7 1965 1880 1880	
			t and a second					
				EC 10 198	52	en e		