1.86w

Longitud

Topo Location

7.5' Loc._____ 15' Loc.____ (calc.)

Company BL Burge


Farm Fairfield-Peterson # 12

7.5' Quad Wallace

District GRANT

WELL LOCATION PLAT


County 103 Permit 30985

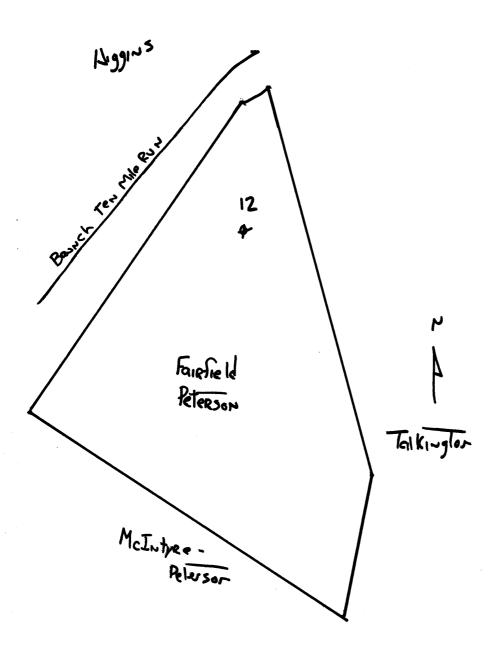




STATE OF WEST VIRGINIA

DEPARTMENT OF MINES

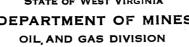


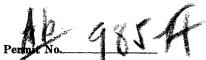

Total Depth

kp.	4881			RECORE			•
Permyt No	102					Oil or Ga	as Well (KIND)
Company B. L. Burge Address 1232-16th, St. Parkersburg, W. Va. Fairfield - Peterson				Casing and Tubing	Used in Drilling	Left in Well	Packers
Farm			Acres	Size			
				16			Kind of Packer
		Weden		13			,
		_County_Wetse		10	318		Size of
		fee by		81/4	1530		Dize oi
		Address		65%	2236	2236	Depth set
Mineral rights a				5 3/16	2394	2394	
Address							Perf. top
Drilling commenced 3-21-1993 Drilling completed 5-15-1993				2			Perf. bottom
Date Shot From To				Liners Used	4 工 4 度	633	Perf. top
		10					Perf. bottom
		in					
			CASING CEMENTED SIZE No. Ft. Date				
Volume	•		Cu. Ft.				
Rock Pressure	×	lbs	hrs.				
Oil			_bbls., 1st 24 hrs.	COAL WAS E	NCOUNTERED A	AT	FEETINCHES
Fresh water		feet	feet	FEE	rINCH	ES	FEETINCHES
Salt water		feet	feet	FEE'	TINCH	ES	FEETINCHES
Formation	Color	Hard or Soft	Тор	Bottom	Oil, Gas or Water	Depth Found	Remarks
Pitts.	oal		965	972			
Denkard	Sand		1480	1636			
Big Inj			2255	2379	A		

3088

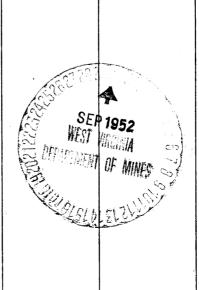

(Over)