

New Location...   
 Drill Deeper...   
 Abandonment...  1567

Company Hope Natural Gas Co.  
 Address Clarksburg, W.Va.  
 Farm Catherine Carlin  
 Tract \_\_\_\_\_ Acres 335 Lease No. 18765  
 Well (Farm) No. \_\_\_\_\_ Serial No. As Shown  
 Elevation (Spirit Level) As Shown  
 Quadrangle Centerpoint  
 County Wetzel District Grant  
 Engineer Wm Powers  
 Engineer's Registration No. 900  
 File No. \_\_\_\_\_ Drawing No. \_\_\_\_\_  
 Date 4-28-51 Scale 1" = 40 P

STATE OF WEST VIRGINIA  
 DEPARTMENT OF MINES  
 OIL AND GAS DIVISION  
 CHARLESTON

**WELL LOCATION MAP**

FILE NO. Wet-901-A-#1567  
Wet-995-A-#5318

+ Denotes location of well on United States Topographic Maps, scale 1 to 62,500, latitude and longitude lines being represented by border lines as shown.

- Denotes one inch spaces on border line of original tracing.



STATE OF WEST VIRGINIA  
DEPARTMENT OF MINES  
OIL AND GAS DIVISION

1432

Centerpoint

WELL RECORD

Permit No. 9957A


Oil or Gas Well Gas  
(KIND)

Company Hope Natural Gas Company  
 Address 445 West Main St. Clarksburg, W. Va.  
 Farm Catherine Carlin Acres 335  
 Location (waters) \_\_\_\_\_  
 Well No. 5318 Elev. 1022'  
 District Grant County Wetzel  
 The surface of tract is owned in fee by \_\_\_\_\_  
 Address \_\_\_\_\_  
 Mineral rights are owned by \_\_\_\_\_  
 Address \_\_\_\_\_  
 Drilling commenced June 6, 1912  
 Drilling completed Aug. 1, 1912  
 Date Shot No record From \_\_\_\_\_ To \_\_\_\_\_  
 With \_\_\_\_\_  
 Open Flow /10ths Water in \_\_\_\_\_ Inch  
 /10ths Merc. in \_\_\_\_\_ Inch  
 Volume \_\_\_\_\_ Cu. Ft.  
 Rock Pressure \_\_\_\_\_ lbs. \_\_\_\_\_ hrs.  
 Oil None recorded bbls., 1st 24 hrs.  
 Fresh water No record feet \_\_\_\_\_ feet  
 Salt water No record feet \_\_\_\_\_ feet

Casing and Tubing	Used in Drilling	Left in Well	Packers
Size			
16			Kind of Packer _____
13			
10			Size of _____
8 1/4	1253	1253	
6 5/8	2032	2032	Depth set _____
5 3/16			
3			Perf. top _____
2			Perf. bottom _____
Liners Used			Perf. top _____
			Perf. bottom _____

CASING CEMENTED \_\_\_\_\_ SIZE \_\_\_\_\_ No. Ft. \_\_\_\_\_ Date \_\_\_\_\_  
No cementing  
 COAL WAS ENCOUNTERED AT 757 FEET 84 INCHES  
 \_\_\_\_\_ FEET \_\_\_\_\_ INCHES FEET \_\_\_\_\_ INCHES  
 \_\_\_\_\_ FEET \_\_\_\_\_ INCHES FEET \_\_\_\_\_ INCHES

Formation	Color	Hard or Soft	Top	Bottom	Oil, Gas or Water	Depth Found	Remarks
Surface			0	16			
Pittsburg Coal			757	764			
Big Dunkard			1255	1275			
Gas Sand			1360	1600			
Maxon			1890	1908			
Pencil Cage			2000	2006			
Big L <sub>4</sub> me			2006	2064			
Big Injun			2064	2200	Gas	2088	Show
Thirty Foot			2745	2770			
Stray			2808	2840	Gas	2833 - 38	
Gordon			2876	2887			
4th Sand			2905	2910			
Total Depth				2922'			

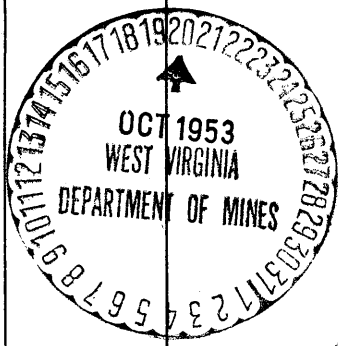

Formation	Color	Hard or Soft	Top	Bottom	Oil, Gas or Water	Depth Found	Remarks

Date October 13, 1953, 19\_\_\_\_

APPROVED Hope Natural Gas Company, Owner

By \_\_\_\_\_ (Title)

*Barley*