

Latitude 39° 35'

Longitude 80° 40'

M. J. Clark
70[±]

Sto. & Beech

N 88 W 119

Sto.

Mary Furbee
25[±]

South 35

F. M. Straight
85[±]

Gum

Edward M^cSweeney
75[±]

Jas. Furbee
50[±]

S 15° 33' E 137.0'

S 35° 10' E 112.6'

6485
El. 822'

N 39° 49' E 45.8'

W.O.

S 83 E 96

Pine & W.O.

Margaret A. Furbee
60[±]

3.11
3.18 W

JUN 8 1954

2.59
2.59

Sh 38 N 8 W 6 FB 1012 P 16-17

- New Location..
- Drill Deeper.....
- Abandonment.....

Company HOPE NATURAL GAS CO.
 Address CLARKSBURG, W. VA.
 Farm Edward M^cSweeney
 Tract _____ Acres 75 Lease No. 35973
 Well (Farm) No. _____ Serial No. 6485
 Elevation (Spirit Level) 822'
 Quadrangle Littleton
 County Wetzel District Green
 Engineer W. M. Bowers
 Engineer's Registration No. 900
 File No. _____ Drawing No. _____
 Date 23 April 54 Scale 1" = 20'

STATE OF WEST VIRGINIA
 DEPARTMENT OF MINES
 OIL AND GAS DIVISION
 CHARLESTON

WELL LOCATION MAP
 FILE NO. Wet-1005-A

+ Denotes location of well on United States Topographic Maps, scale 1 to 62,500, latitude and longitude lines being represented by border lines as shown.
 - Denotes one inch spaces on border line of original tracing.

EDWARD MCSWEENEY NO. 6485 - HOPE N.G. CO. - WET-1005-A



STATE OF WEST VIRGINIA
DEPARTMENT OF MINES
OIL AND GAS DIVISION

MAY

WELL RECORD

Permit No. 1005-A


Oil or Gas Well Gas
(KIND)

Company Hope Natural Gas Company
 Address 445 West Main St., Clarksburg, W. Va.
 Farm Edward McSweeney Acres 75
 Location (waters) _____
 Well No. 6485 Elev. 822'
 District Green County Wetzel
 The surface of tract is owned in fee by _____
 Address _____
 Mineral rights are owned by _____
 Address _____
 Drilling commenced 3-14-24
 Drilling completed 5-17-24
 Date Shot 5-17-24 From 2559 To 2566
 With 15 Qts Nitro
 Open Flow _____ /10ths Water in _____ Inch
 _____ /10ths Merc. in _____ Inch
 Volume 184 M Cu. Ft.
 Rock Pressure 48 lbs. _____ hrs.
 Oil ~~1674~~ bbls., 1st 24 hrs.
 Fresh water 1XX feet _____ feet
 Salt water 1440 & 1840 feet _____ feet

Casing and Tubing	Used in Drilling	Left in Well	Packers
Size			
16			Kind of Packer _____
13			
10	<u>262</u>	<u>262</u>	Size of _____
8 1/4	<u>1041</u>	<u>1041</u>	
6 5/8	<u>1740</u>	<u>1740</u>	Depth set _____
5 3/16	<u>1981</u>	<u>1981</u>	
3			Perf. top _____
2	<u>2619</u>	<u>Pulled</u>	Perf. bottom _____
Liners Used			Perf. top _____
			Perf. bottom _____

CASING CEMENTED _____ SIZE _____ No. Ft. _____ Date _____
No cementing
 COAL WAS ENCOUNTERED AT 40 FEET 24 INCHES
405 FEET 36 INCHES 480 FEET 36 INCHES
 _____ FEET _____ INCHES _____ FEET _____ INCHES

Formation	Color	Hard or Soft	Top	Bottom	Oil, Gas or Water	Depth Found	Remarks
Coal			40	42			
Sand			325	335			
REXX Coal			405	408			
Limestone			435	?			
Pittsburgh Coal			480	483			
Hard Sand			537	576			
Little Dunkard			914	952	Gas	917	Show
Red Rock			996	1016			
Lime Shells			1106	1116			
1st SALT			1282	1375			
2nd SALT			1404	1532	Water	1440-45	
MAXON			1634	1643	Oil	1634	
Sand			1664	1689			
BIG LIME			1689	1740			
BIG INJUN			1740	1989	Water	1840	
BEREA			2134	2154			
Sand & Lime Shells			2164	2250			
Fifty Foot			2328	2350			
Gritty Lime			2408	2420			
Red Rock			2420	2470			
GORDON			2553	2585	Gas	2556	
Gritty Lime			2602	2609			
Total Depth				2610'			

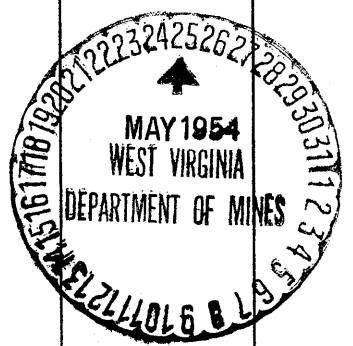

(Over)

NOV 12 1954

