

New Location...
 Drill Deeper.....
 Abandonment.....

MAR 7 1955

4.06
 411 W
 3.02 311

Company CARNEGIE NATURAL GAS
 Address PITTSBURGH, Pa.
 Farm E.S. LOUGH
 Tract _____ Acres 33 Lease No. E7347-73
 Well (Farm) No. 1 Serial No. E-6
 Elevation (Spirit Level) 1220'
 Quadrangle MANNINGTON N.W.
 County WETZEL District CLAY
 Engineer John A. Theobald
 Engineer's Registration No. 1850
 File No. _____ Drawing No. _____
 Date 1-24-55 Scale 1"=30 POLES

STATE OF WEST VIRGINIA
 DEPARTMENT OF MINES
 OIL AND GAS DIVISION
 CHARLESTON

WELL LOCATION MAP
 FILE NO. Wet-1008-A

+ Denotes location of well on United States Topographic Maps, scale 1 to 62,500, latitude and longitude lines being represented by border lines as shown.
 - Denotes one inch spaces on border line of original tracing.



STATE OF WEST VIRGINIA
DEPARTMENT OF MINES
OIL AND GAS DIVISION

1440

WELL RECORD

WELL TO BE ABANDONED

Oil or Gas Well Gas
(KIND)

Permit No. NS-1008 A


Company Carnegie Natural Gas Company
Address 1015 Frick Building, Pittsburgh 19, Pa.
Farm Esa S. Lough Acres 33
Location (waters) Brown's Run
Well No. 6 Elev. 1220
District Clay County Wetzel
The surface of tract is owned in fee by Perry Kirby,
617 Allen Street Address Akron, Ohio
Mineral rights are owned by Flores Lough
75 Vine Street Address Shinnston, W. Va.
Drilling commenced 10-21-10 3-5-19
Drilling completed 1-22-11 4-8-19
Date Shot _____ From _____ To _____
With _____

Casing and Tubing	Used in Drilling	Left in Well	Packers
Size			
16			Kind of Packer
13			
10			Size of
8 1/4	1330	1330	
6 5/8	2128	2128	Depth set
5 3/16	2984	2984	
3			Perf. top
2			Perf. bottom
Liners Used			Perf. top
			Perf. bottom

Open Flow _____ /10ths Water in _____ Inch
_____ /10ths Merc. in _____ Inch
Volume _____ Cu. Ft.
Rock Pressure _____ lbs. _____ hrs.
Oil _____ bbls., 1st 24 hrs.
Fresh water _____ feet _____ feet
Salt water _____ feet _____ feet

CASING CEMENTED _____ SIZE _____ No. Ft. _____ Date _____
COAL WAS ENCOUNTERED AT 930 FEET _____ INCHES
_____ FEET _____ INCHES FEET _____ INCHES
_____ FEET _____ INCHES FEET _____ INCHES

Formation	Color	Hard or Soft	Top	Bottom	Oil, Gas or Water	Depth Found	Remarks
Pittsburgh Coal			930	937			
2nd Salt Sand			1688		Gas	1708-1718	
		Total Depth		1731			
2nd Salt Sand				1968			
Maxon			1986	2013			
Little Line			2095	2105			
Pencil Cave			2105	2110			
Big Line			2110	2174			
Big Injun			2174	2415	Gas	2179-2196	
Gantz			2745	2766	Gas	2751-2755	
Fifty Foot			2915	2950			
Gordon Stray			2974				
Gordon Sand			3002		Gas	3010-3016	
		Total Depth		3017			

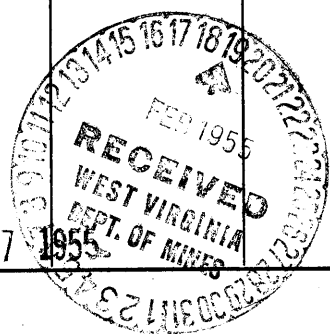

(Over)

