

MAY 16 1955

Company CARNEGIE NATURAL GAS
 Address PITTSBURGH PA.
 Farm RUFUS LONG
 Tract _____ Acres 155 Lease No. E10968-71
 Well (Farm) No. 3 Serial No. E1237
 Elevation (Spirit Level) 1260
 Quadrangle LITTLETON NE
 County WETZEL District CENTER
 Engineer John B. Book
 Engineer's Registration No. 1850
 File No. _____ Drawing No. _____
 Date 4-19-55 Scale 1" = 660'

STATE OF WEST VIRGINIA
DEPARTMENT OF MINES
OIL AND GAS DIVISION
CHARLESTON

WELL LOCATION MAP
FILE NO. Wet-1010-A

+ Denotes location of well on United States Topographic Maps, scale 1 to 62,500, latitude and longitude lines being represented by border lines as shown.
- Denotes one inch spaces on border line of original tracing.

RUFUS LONG NO. 3 (E-1237) - CARNEGIE NATURAL GAS CO. - WET-1010-A



STATE OF WEST VIRGINIA
DEPARTMENT OF MINES
OIL AND GAS DIVISION

1434

Handwritten signature
Permit No. 1010-A

WELL RECORD
WELL TO BE ABANDONED

Oil or Gas Well GAS
(KIND)


Company Carnegie Natural Gas Company
Address 1015 Frick Building, Pittsburgh 19, Pa.
Farm Rufus Long Acres 155
Location (waters) _____
Well No. 1237 Elev. 1260
District Center County Wetzel
The surface of tract is owned in fee by Rufus Long
Woodruff Address W. Va.
Mineral rights are owned by Rufus Long, Woodruff, W. Va.
& Joseph Shiben Address New Martinsville, W. Va.
Drilling commenced 1-23-24 D.D. 7-10-34
Drilling completed 3-4-24 D.D. 8-15-34
Date Shot From 2353 To 2359
3177 3186
With _____

Casing and Tubing	Used in Drilling	Left in Well	Packers
Size			Kind of Packer
16			
13			
10	<u>348</u>	<u>None</u>	Size of
8 1/4	<u>1622</u>	<u>1622</u>	
6 1/2	<u>2107</u>	<u>2107</u>	Depth set
3/16			
3			Perf. top
2	<u>3206</u>	<u>3206</u>	Perf. bottom
Liners Used			Perf. top
			Perf. bottom

Open Flow _____ /10ths Water in _____ Inch
_____ /10ths Merc. in _____ Inch
Volume _____ Cu. Ft.
Rock Pressure _____ lbs. _____ hrs.
Oil _____ bbls., 1st 24 hrs.
Fresh water _____ feet _____ feet
Salt water 2060 feet _____ feet

CASING CEMENTED _____ SIZE _____ No. Ft. _____ Date _____
COAL WAS ENCOUNTERED AT 1140 FEET _____ INCHES
_____ FEET _____ INCHES FEET _____ INCHES
_____ FEET _____ INCHES FEET _____ INCHES

Formation	Color	Hard or Soft	Top	Bottom	Oil, Gas or Water	Depth Found	Remarks
Pittsburgh Coal			1140	1146			
Little Dunkard			1515	1565			
Big Dunkard			1615	1680			
Gas Sand			1755	1860			
First Salt Sand			1930	1965			
Second Salt Sand			1995	2080	Water	2060	
Maxon Sand			2233	2280			
Big Lime			2280	2334			
Big Injun			2334		Gas	2340-2349	
					Show Oil	2353-2355	
					Oil	2359	
		Total Depth		2355			
Big Injun				2585			
Thirty Foot Sand			2952	2959			
Gordon Stray			3168	3203	Gas	3177	
					Oil	3184	
		Total Depth		3206			

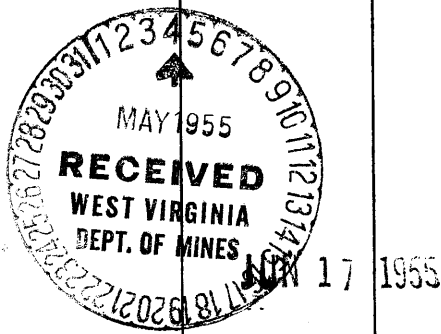

Formation	Color	Hard or Soft	Top	Bottom	Oil, Gas or Water	Depth Found	Remarks

Date May 2, 1955

APPROVED Carnegie Natural Gas Company, Owner

By *D. H. Walker*
(Title) Land Agent