


Latitude 39° 40'



Longitude 80° 35'

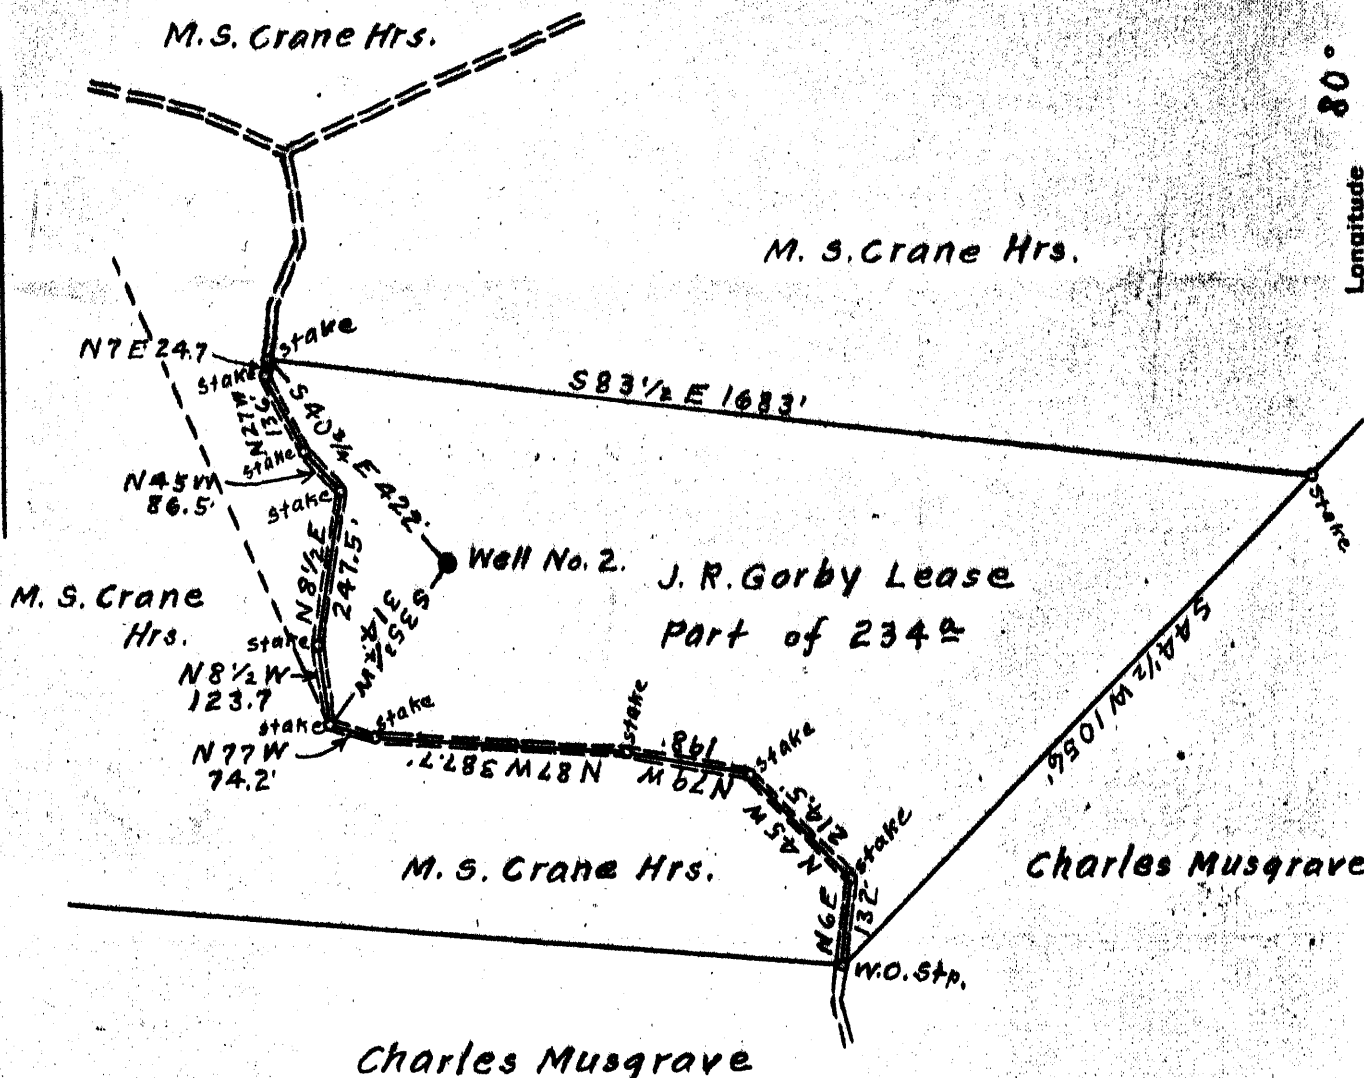

2.10
 2.14 W
 2.64
 2.68

surface owned by M.S. Crane Hrs.
 Address: Mrs. Ona Crane, Star Route, Wileyville, W.Va.
 Coal owned by Beatrice Yeater, 2 1/4 Acres.
 Address: 235 Virginia St. New Martinsville, W.Va.

New Location...
 Drill Deeper...
 Abandonment...

AUG. 6 1956

On 800' Map N78. Sqs. N15 E1.

Company William Moses
 Address Salem, W.Va.
 Farm J.R. Gorby
 Tract Part of Acres 234 Lease No. _____
 Well (Farm) No. 2 Serial No. _____
 Elevation (Spirit Level) Floor - 1487.02
Ground - 1485.52
 Quadrangle Littleton
 County Wetzel District Center
 Engineer Olsworth Haines
 Engineer's Registration No. 2221
 File No. _____ Drawing No. _____
 Date Apr. 27th, 1956. Scale 1" = 300 Feet

STATE OF WEST VIRGINIA
 DEPARTMENT OF MINES
 OIL AND GAS DIVISION
 CHARLESTON

WELL LOCATION MAP
 FILE NO. Wet-1028-A

+ Denotes location of well on United States Topographic Maps, scale 1 to 62,500, latitude and longitude lines being represented by border lines as shown.

- Denotes one inch spaces on border line of original tracing.



STATE OF WEST VIRGINIA
DEPARTMENT OF MINES
OIL AND GAS DIVISION

1403

Quadrangle Linton

WELL RECORD

Permit No. Kit 1028-A

Oil or Gas Well _____ (KIND)

Company <u>William Moses</u>	Casing and Tubing	Used in Drilling	Left in Well	Packers
Address <u>Jasper, W. Va.</u>	Size			
Farm <u>J. R. Corby</u> Acres <u>234</u> ^{part of}	16			Kind of Packer
Location (waters)	13			
Well No. <u>2</u> Elev. <u>1485</u>	10		860	Size of
District <u>Center</u> County <u>Wetzel</u>	8 1/4		1865	Depth set
The surface of tract is owned in fee by _____	6%		2550	
Mineral rights are owned by <u>Beatrice Yeater</u>	6%		2850	
Address <u>New Martintown, W. Va.</u>	3			Perf. top
Drilling commenced <u>5/20/04</u>	2			Perf. bottom
Drilling completed <u>4/22/05</u>	Liners Used			Perf. top
Date Shot _____ From _____ To _____				Perf. bottom
With _____				

Open Flow _____ /10ths Water in _____ Inch

_____ /10ths Merc. in _____ Inch

Volume _____ Cu. Ft.

Rock Pressure _____ lbs. _____ hrs.

Oil _____ bbls., 1st 24 hrs.

Fresh water _____ feet _____ feet

Salt water _____ feet _____ feet


CASING CEMENTED _____ SIZE _____ No. Ft. _____ Date _____

COAL WAS ENCOUNTERED AT 1403 FEET 72 INCHES

_____ FEET _____ INCHES _____ FEET _____ INCHES

_____ FEET _____ INCHES _____ FEET _____ INCHES

Formation	Color	Hard or Soft	Top	Bottom	Oil, Gas or Water	Depth Found	Remarks
			1403	1409			
			1858	1873			
			2223	2399			
			2645	2708			
			2708	2813			
			3425	3446			
			Total Depth	3453			

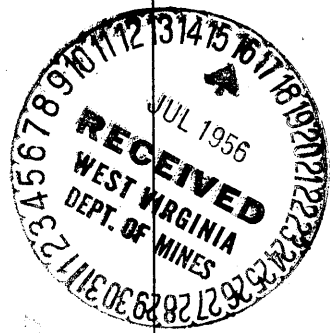

(Over)

OCT 26 1956