



Latitude 39° 40'

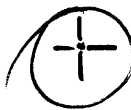

Longitude 80° 25'

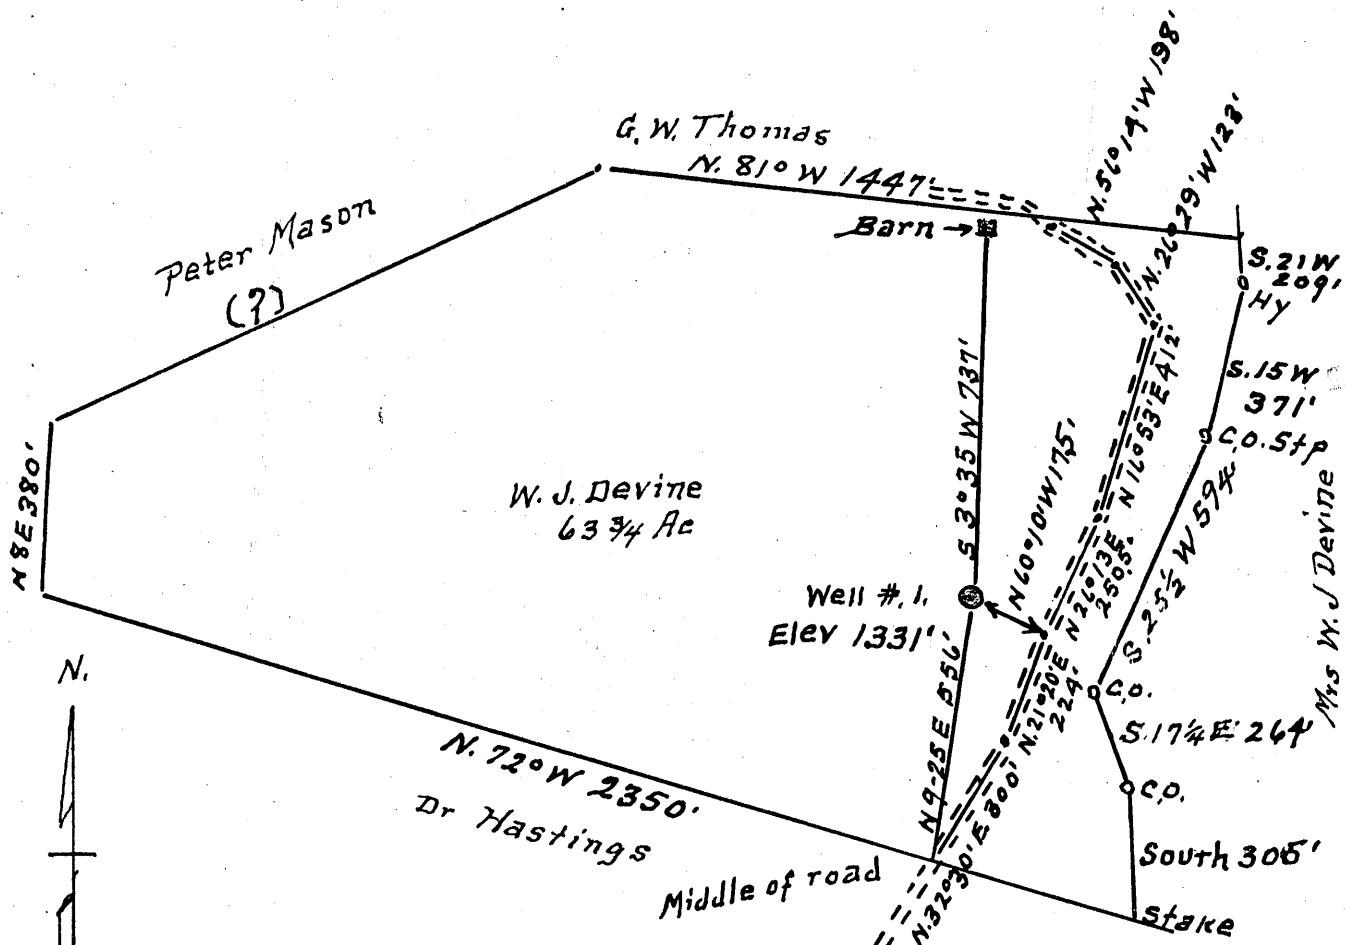

N.



New Location...
 Drill Deeper...
 Abandonment...

JUN 17 1957

Company Truman Smith
 Address Hundred W. Va.
 Farm W. J. Devine
 Tract 1 Acres 63 3/4 Lease No. _____
 Well (Farm) No. 1 Serial No. 1160
 Elevation (Spirit Level) 1331'
 Quadrangle Mannington
 County Wetzel District Church
 Engineer A. L. Headley
 Engineer's Registration No. 2021
 File No. _____ Drawing No. _____
 Date 5-17-57 Scale 1" = 400'

STATE OF WEST VIRGINIA
 DEPARTMENT OF MINES
 OIL AND GAS DIVISION
 CHARLESTON

WELL LOCATION MAP
 FILE NO. Wet-1059-A

+ Denotes location of well on United States Topographic Maps, scale 1 to 62,500, latitude and longitude lines being represented by border lines as shown.

- Denotes one inch spaces on border line of original tracing.



STATE OF WEST VIRGINIA
DEPARTMENT OF MINES
OIL AND GAS DIVISION

Handwritten: 526, 1487

Quadrangle Mannington

Permit No. 1059-A

WELL RECORD

Oil or Gas Well _____ (KIND)

Company Service Pipe & Supply Co.
Address Hundred, W. Va.
Farm W. J. Devine Acres 64
Location (waters) _____
Well No. 1-1160 Elev 1331
District Church County Wetzel
The surface of tract is owned in fee by _____
Address _____
Mineral rights are owned by _____
Address _____
Drilling commenced June 26, 1907
Drilling completed August 16, 1907
Date Shot _____ From _____ To _____
With _____
Open Flow _____ /10ths Water in _____ Inch
_____ /10ths Merc. in _____ Inch
Volume _____ Cu. Ft.
Rock Pressure _____ lbs. _____ hrs.
Oil _____ bbls., 1st 24 hrs.
WELL ACIDIZED _____
WELL FRACTURED _____

Casing and Tubing	Used in Drilling	Left in Well	Packers
Size			Kind of Packer _____
16			
13			
10	156	156	Size of <u>4"</u>
8 1/4	1450	1450	
6 5/8	2250	2250	Depth set _____
5 3/16			
3			Perf. top _____
2 4	3314	3314	Perf. bottom _____
Liners Used			Perf. top _____
			Perf. bottom _____

CASING CEMENTED _____ SIZE _____ No. Ft. _____ Date _____


COAL WAS ENCOUNTERED AT _____ FEET _____ INCHES
_____ FEET _____ INCHES FEET _____ INCHES
_____ FEET _____ INCHES FEET _____ INCHES

RESULT AFTER TREATMENT _____

ROCK PRESSURE AFTER TREATMENT _____

Fresh Water _____ Feet Salt Water _____ Feet

Formation	Color	Hard or Soft	Top	Bottom	Oil, Gas or Water	Depth	Remarks
Soil				14			
Lime & Slate			14	720			
Waynesburg Coal			720	724			
Sand, Lime			724	957			
Mapletown Coal			957	962			
Lime			962	1055			
Pittsburgh Coal			1055	1062			
Slate & red Rock			1062	1405			
Little Dunkard			1405	1453			
Big Dunkard			1510	1590			
Gas Sand			1672	1697			
Salt Sand			1840	1940			
Maxon sand			2168	2243			
Gas pay			2200	2228			
Pencil Slate			2243	2246			
Big Lime			2246	2325			
Big Injun			2325	2550			
Slate & Shells			2550	2610			
Gritty Lime			2610	2710			
Broken Lime			2710	2750			
Slate & Shells			2750	3024			
50 foot			3024	3040			
Broken Lime			3040	3050			
30 foot			3060	3094			
Slate & shells			3094	3113			
Lime			3113	3123			
Pink rock			3123	3124			
Gorden gray sand			3124	3148			
Slate & shells			3148	3177			

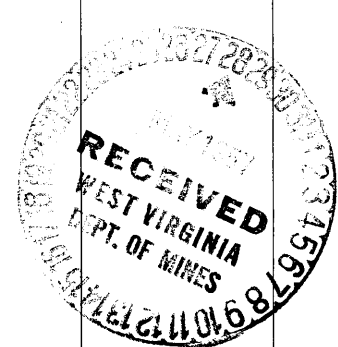

(over)

DEC 6 1957

Formation	Color	Hard or Soft	Top	Bottom	Oil, Gas or Water	Depth Found	Remarks
Gordon sand			3177	3227			
Slate & shells			3227	3252			
4th sand			3252	3280			
Total depth			3314				

Date _____, 19____

APPROVED _____, Owner

By _____
(Title)