


Latitude 39° 35'

Longitude 80° 25'

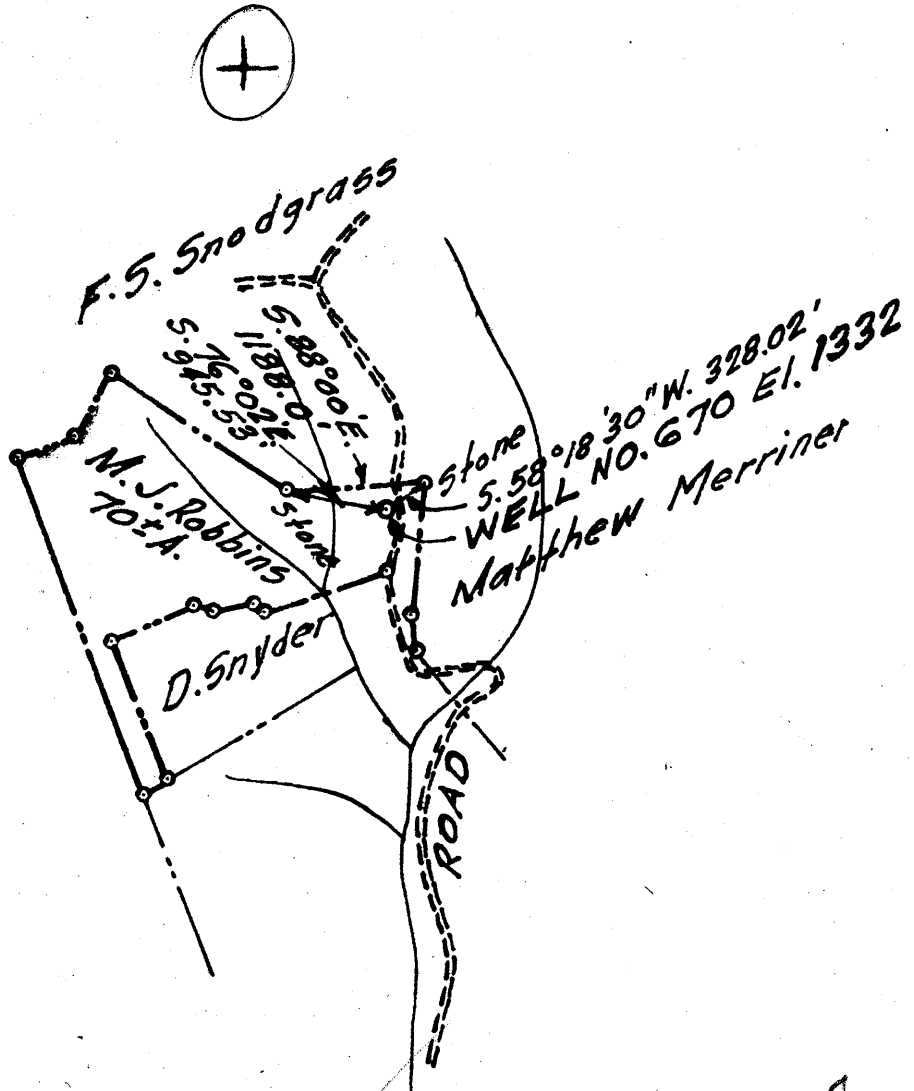

New Location
 Drill Deeper
 Abandonment

MAR 15 1959

437
 44 W
 300 9.27

Company A. M. Snider
 Address 60 Sunset Dr., Fairmont, W. Va.
 Farm M. J. Robbins
 Tract _____ Acres 70± Lease No. _____
 Well (Farm) No. 670 Serial No. _____
 Elevation (Spirit Level) El. 1332
 Quadrangle Mappington
 County Wetzel District Grant
 Engineer Wm. H. Hedges
 Engineer's Registration No. 1868
 File No. A. M. S. Drawing No. 10
 Date Sept. 23, 1958 Scale 1" = 80 P.

STATE OF WEST VIRGINIA
 DEPARTMENT OF MINES
 OIL AND GAS DIVISION
 CHARLESTON

WELL LOCATION MAP
 FILE NO. Wet-1090-A

+ Denotes location of Well on United States Topographic Maps. Scale 1 to 62,500, latitude and longitude lines being represented by border lines as shown.
 - Denotes one inch spaces on border line of original tracing.