

Company South Penn Natural Gas Co.
 Address Parkersburg, W. Va.
 Farm Helen M. Jamison
 Tract _____ Acres 202 Lease No. 15545
 Well (Farm) No. 3 & 6 Serial No. _____
 Elevation (Spirit Level) (3) 1270.60 ch. (6) 1184.51 ch.
 Quadrangle Centerpoint
 County Wetzel District Green
 Engineer Al. Thelheit
 Engineer's Registration No. 2534
 File No. 1269 Drawing No. _____
 Date May 19, 1959 Scale 1" = 40 Poles or 660'


STATE OF WEST VIRGINIA
 DEPARTMENT OF MINES
 OIL AND GAS DIVISION
 CHARLESTON

WELL LOCATION MAP

FILE NO. Wet-1094-A-#3
Wet-1095-A-#6

+ Denotes location of well on United States Topographic Maps, scale 1 to 62,500, latitude and longitude lines being represented by border lines as shown.

- Denotes one inch spaces on border line of original tracing.

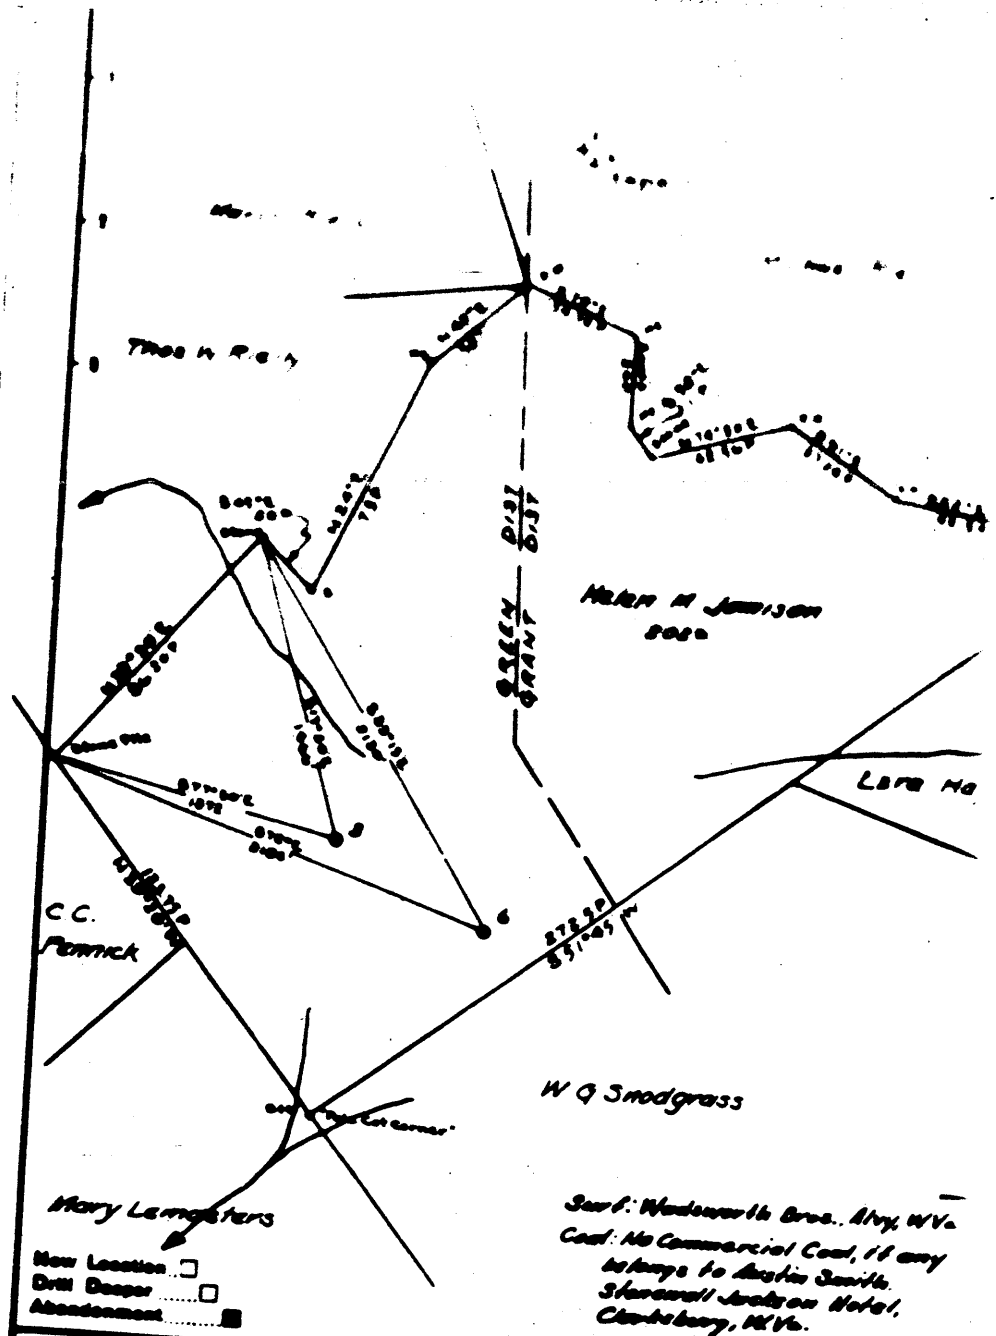

Map N 28 N 3 W 2-3

Company	South Penn Natural Gas Co.	
Address	Parkersburg, W. Va.	
Farm	Helen M. Jamison	
Tract	Acres 2.02	Lease No. 15945
Well (Farm) No.	356	Serial No.
Elevation (Spill Level)	4127.60 ft. (1985.10 ft.)	
Operator	C. C. Farnick	

STATE OF WEST VIRGINIA
 DEPARTMENT OF MINES
 OIL AND GAS DIVISION
 CHARLESTON

WELL LOCATION MA
 FILE NO. REC-1094-R-1
 W.V. - 1985

WELL RECORD

Permit No. _____

Oil or Gas Well _____ (1922)

Company South Penn Natural Gas Co. Inc.
 Address P. O. Box 1280, Parsons, W. Va.
 Farm H. W. Jamison Acres 202
 Location (waters) _____
 Well No. 3 Elev. 1270.60
 District Grant County Putnam
 The surface of tract is owned in fee by Madsonorth Bros.
 Address Alva, W. Va.
 Mineral rights are owned by Union National Bank, Att.
 Address Clermont, W. Va.
 Drilling commenced 5-17-99
 Drilling completed 7-15-99
 Date Shot 10-12-06 at 3168 To _____
 With 12-23-10 at 3164

Casing and Tubing	Used in Drilling	Left in Well	Packers
Size			
10			Kind of Pack
12			
10	678	0	Size of
8 1/2	1556	0	
6 1/2	2367	0	Depth set
5 1/2	2575	2575	
3	1816	1816	Perf. top
			Perf. bottom
Lines Used			Perf. top
			Perf. bottom

Open Flow /10ths Water in _____ Inch
 /10ths Merc. in _____ Inch
 Volume _____ Cu. Ft.
 Rock Pressure _____ lbs. _____ hrs.
 Oil _____ bbls. 1st 24 hrs.
 Fresh water _____ feet
 Salt water _____ feet

CASING CEMENTED _____ SIZE _____ No. Ft. _____ Date _____
 COAL WAS ENCOUNTERED AT 1090 FEET 2 INCHES
 _____ FEET _____ INCHES _____ FEET _____ INCHES
 _____ FEET _____ INCHES _____ FEET _____ INCHES

Formation	Color	Hard or Soft	Top	Bottom	Oil, Gas or Water	Depth Found	Remarks
Pittsburgh Coal			1090				
Blk Injun			2400	2550	Gas	2475	Show
Stray Sand			3138		Oil	3158	Show
Gordon Sand			3169	3185	Oil	3172	
TOTAL DEPTH				3189			



AFFIDAVIT OF PLUGGING AND FILLING WELL

AFFIDAVIT SHOULD BE MADE IN TRIPPLICATE. ONE COPY TO BE FILED IN THE COUNTY CLERK'S OFFICE, ONE COPY TO BE FILED IN THE COUNTY ENGINEER'S OFFICE AND THE THIRD COPY AND OTHER COPIES IF REQUIRED SHOULD BE MAILED TO THE ADDRESS

S. Austin Smith
COAL OPERATOR OR OWNER
 Marshall Jackson (Jr.)
 Martinsburg, West Virginia
ADDRESS

SOUTH PINE REFINING CO. COMPANY
COAL OPERATOR
 P. O. Box 1222, Martinsburg, West Virginia
ADDRESS

COAL OPERATOR OR OTHER
ADDRESS
 Union National Bank, Attorney
ADDRESS
 Martinsburg, West Virginia
ADDRESS

WELL LOCATION
 District
 County
 Well No. 3
 E. H. Jones
 Form

STATE INSPECTOR SUPERVISING PLUGGING

AFFIDAVIT

STATE OF WEST VIRGINIA.

County of Taylor

being first duly sworn according to law depose and say that they are experienced in the work of plugging and filling oil and gas wells and were employed by well operator, and participated in the work of plugging and filling the above well, that said work was commenced on the 25 day of August, 1957, and that the well was plugged and filled in the following manner:

BAND OR ZONE RECORD	FILLING MATERIAL		PLUGGING	CASINGS	
	CONTENT	FROM TO		NO.	NO.
clay	cement	3109 3112	5"	1190	1189
	rock	3108 3109	3"	1016	
	rock	3107 3108			
cut 5" at 1120	plug	1150			
	cement	1150 1140			
	rock	1140 1135			
	dry	1135 1120			
	cement	1120 1090			
	clay	1090 716			
	cement	716 706			
	rock	706 701			
	clay to surface				
	Exact manner as described in rule 23 of the Reg.				
COAL BEANS					
(NAME)					
(NAME)					
(NAME)					
(NAME)					

and that the work of plugging and filling said well was completed on the 6 day of Sept., 1957.

And further deponents saith not.

Sworn to and subscribed before me this 11 day of Sept., 1957.

George Gregory
 State Inspector