

Latitude 39° 35'

Longitude 80° 40'

A. McHENRY
100 AC.


E. A FLUHARTY
HEIRS

WILLIAM WEEKLEY
92 AC.

AMANDA WRIGHT

HOGHE HEIRS
247 1/2 AC.

S. & E YOUST
23 AC.

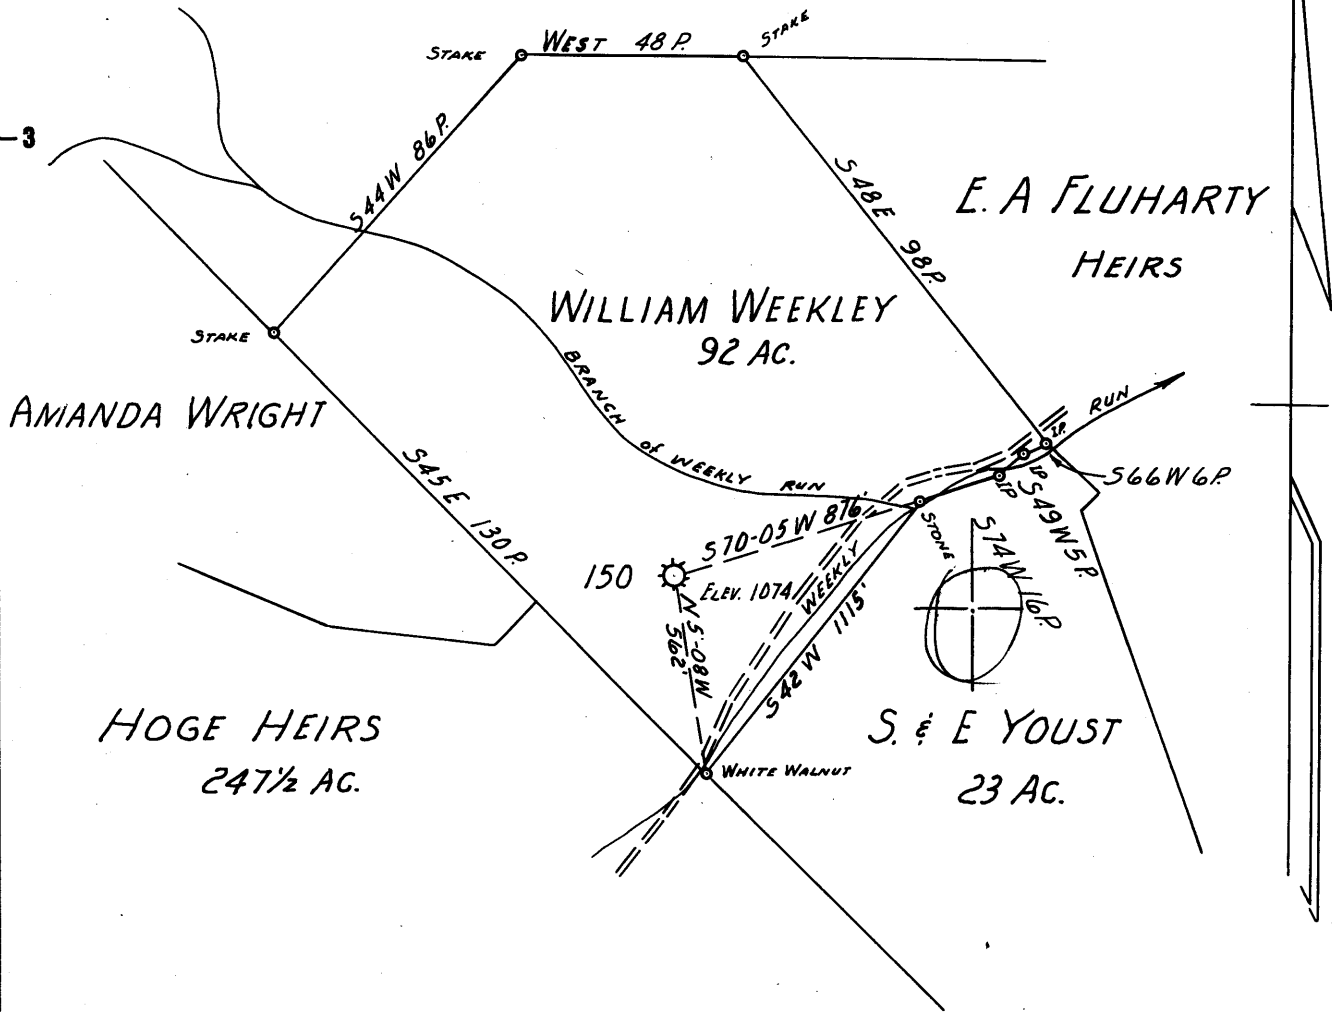

APR 10 1961

New Location
Drill Deeper
Abandonment

MAP SHEET 46 N5W5 FB 1237 Pg 9

2.41
~~2.40 W~~
5.54
J.G. R

Company HOPE NATURAL GAS CO.
 Address CLARKSBURG, W. VA.
 Farm WILLIAM WEEKLEY
 Tract _____ Acres 92 AC. Lease No. 750
 Well (Farm) No. _____ Serial No. 150
 Elevation (Spirit Level) 1074
 Quadrangle LITTLETON
 County WETZEL District GREEN
 Engineer Guy H Bradley
 Engineer's Registration No. 2425
 File No. _____ Drawing No. _____
 Date Nov. 14, 1960 Scale 1" = 40P.

STATE OF WEST VIRGINIA
DEPARTMENT OF MINES
OIL AND GAS DIVISION
CHARLESTON

WELL LOCATION MAP
FILE NO. Wet-1126-A

+ Denotes location of well on United States Topographic Maps, scale 1 to 62,500, latitude and longitude lines being represented by border lines as shown.

- Denotes one inch spaces on border line of original tracing.



1507

STATE OF WEST VIRGINIA
DEPARTMENT OF MINES
OIL AND GAS DIVISION

LITTLETON
CENTER POINT

Quadrangle

WELL RECORD

Oil or Gas Well **Gas**
(KIND)

Permit No. 1126A

Company Hope Natural Gas Company
Address Clarksburg, W. Va.
Farm Wm. Weekley Acres 9 1/2
Location (waters) _____
Well No. 150 Elev. 1274
District Green County Wetzel
The surface of tract is owned in fee by _____
Address _____
Mineral rights are owned by _____
Address _____


Drilling commenced Jan. 13, 1900
Drilling completed Mar. 14, 1900
Date Shot April, 1905 From Nonrecord
With _____
Open Flow _____ /10ths Water in _____ Inch
_____ /10ths Merc. in _____ Inch
Volume Exhausted Cu. Ft.
Rock Pressure ?? lbs. hrs.
Oil _____ bbls., 1st 24 hrs.
WELL ACIDIZED No
WELL FRACTURED No

Casing and Tubing	Used in Drilling	Left in Well	Packers
Size			Kind of Packer
16			No record
13			Size of
10	505'		Depth set
8 3/4	1318'		
6 5/8	2335'	2335'	
5 3/16			
4"	3002'6"	3002'6"	Perf. top
2	2992'	2992'	Perf. bottom
Liners Used			Perf. top
			Perf. bottom

CASING CEMENTED _____ SIZE _____ No. Ft. _____ Date _____
No cementing
COAL WAS ENCOUNTERED AT 800 FEET Show INCHES
_____ FEET _____ INCHES FEET _____ INCHES
_____ FEET _____ INCHES FEET _____ INCHES

RESULT AFTER TREATMENT _____
ROCK PRESSURE AFTER TREATMENT _____
Fresh Water Not recorded Feet _____ Salt Water _____ Feet _____

Formation	Color	Hard or Soft	Top	Bottom	Oil, Gas or Water	Depth	Remarks
Pitts. Coal			800	????	Show		
Injun sand			2095	2280			
Stray sand			2850	2856	Gas	2856	
Gordon sand			2859	2879	Oil	2870	
Total Depth				2903			
Pocket				2970			

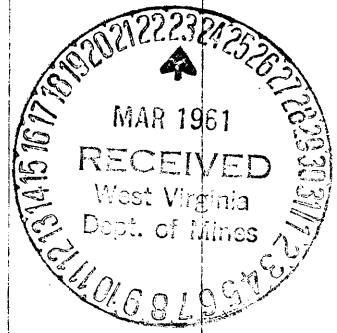

March 22, 1961
Jack Bailey
Hope Natural Gas Co.

AUG 2 1961