

New Location...   
 Drill Deeper.....   
 Abandonment.....

MAY 22 1961

MAP SH. 47. SQ. N. T. W. 8. F. B. 1029 P. 38

Company	HOPE NATURAL GAS CO.
Address	CLARKSBURG, W.VA.
Farm	LEWIS CONLEY
Tract	Acres 20 Lease No. 4817
Well (Farm) No.	Serial No. 700
Elevation (Spirit Level)	1101'
Quadrangle	NEW MARTINSVILLE
County	WETZEL District GREENE
Engineer	GUY H. BRADLEY
Engineer's Registration No.	2425
File No.	Drawing No.
Date	10-31-60 Scale 1"=20 Poles

STATE OF WEST VIRGINIA  
 DEPARTMENT OF MINES  
 OIL AND GAS DIVISION  
 CHARLESTON

WELL LOCATION MAP  
 FILE NO. Wet-1132-A

+ Denotes location of well on United States Topographic Maps, scale 1 to 62,500, latitude and longitude lines being represented by border lines as shown.

- Denotes one inch spaces on border line of original tracing.

LEWIS CONLEY No-700 HOPE No 610 WET-1132-A



1574

STATE OF WEST VIRGINIA  
DEPARTMENT OF MINES  
OIL AND GAS DIVISION

Quadrangle New Martinsville

Permit No. 1132-A

WELL RECORD

Oil or Gas Well Gas  
KIND

Company Hope Natural Gas Company  
Address Clarksburg, W. Va.  
Farm Lewis Conley Acres 70

Location (waters) \_\_\_\_\_  
Well No. 700 Elev. 1101  
District Green County Wetzel

The surface of tract is owned in fee by \_\_\_\_\_  
Address \_\_\_\_\_

Mineral rights are owned by \_\_\_\_\_  
Address \_\_\_\_\_

Drilling commenced Mar 8, 1905  
Drilling completed May 7, 1905  
Date Shot 10/2/36 From \_\_\_\_\_ To \_\_\_\_\_  
With 30 qts.

Open Flow \_\_\_\_\_ /10ths Water in \_\_\_\_\_ Inch  
\_\_\_\_\_ /10ths Merc. in \_\_\_\_\_ Inch

Volume No record Cu. Ft.  
Rock Pressure No record lbs. \_\_\_\_\_ hrs.

Oil \_\_\_\_\_ bbls., 1st 24 hrs.  
WELL ACIDIZED No

WELL FRACTURED No

RESULT AFTER TREATMENT \_\_\_\_\_

ROCK PRESSURE AFTER TREATMENT \_\_\_\_\_

Fresh Water \_\_\_\_\_ Feet


Salt Water \_\_\_\_\_ Feet

Formation	Color	Hard or Soft	Top	Bottom	Oil, Gas or Water	Depth	Remarks
Pitts. Coal			755				
Salt sand			1595	1900	Water		
Injun sand			2040	2280	Gas		
Gordon sand			2831	2857	Gas		
Total Depth				2857			
Pocket				2889			

Casing and Tubing	Used in Drilling	Left in Well	Packers
Size			
16			Kind of Packer <u>W &amp; A</u>
11			Size of <u>5 x 3</u>
10	<u>118'</u>		Depth set <u>2813</u>
8 1/4	<u>1240'</u>		
6 3/8	<u>1951'</u>	<u>1951'</u>	
5 3/8	<u>2414'9"</u>	<u>2414'9"</u>	
3	<u>2888'</u>		Perf. top _____
<u>2 3"</u>	<u>2904'</u>	<u>2904'</u>	Perf. bottom _____
Liners Used _____			Perf. top _____
			Perf. bottom _____

CASING CEMENTED \_\_\_\_\_ SIZE \_\_\_\_\_ No. Ft. \_\_\_\_\_ Date \_\_\_\_\_  
No record

COAL WAS ENCOUNTERED AT \_\_\_\_\_ FEET \_\_\_\_\_ INCHES  
\_\_\_\_\_ FEET \_\_\_\_\_ INCHES  
\_\_\_\_\_ FEET \_\_\_\_\_ INCHES

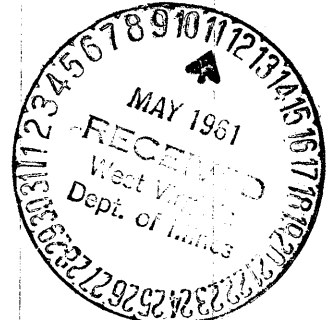

APR 6 1962

May 10, 1961

H. N. G. Co.