

Latitude

—
|.22s
1.41w

Longitude

Topo Location

7.5' Loc. _____ 15' Loc. _____
_____ (calc.) _____

Company AM Smides

Farm Isaac Smith

15' Quad _____
(sec.)

7.5' Quad Pine Grove


District Green

WELL LOCATION PLAT

County 103 Permit 31137

Latitude 39° 40'

Longitude 80° 40'

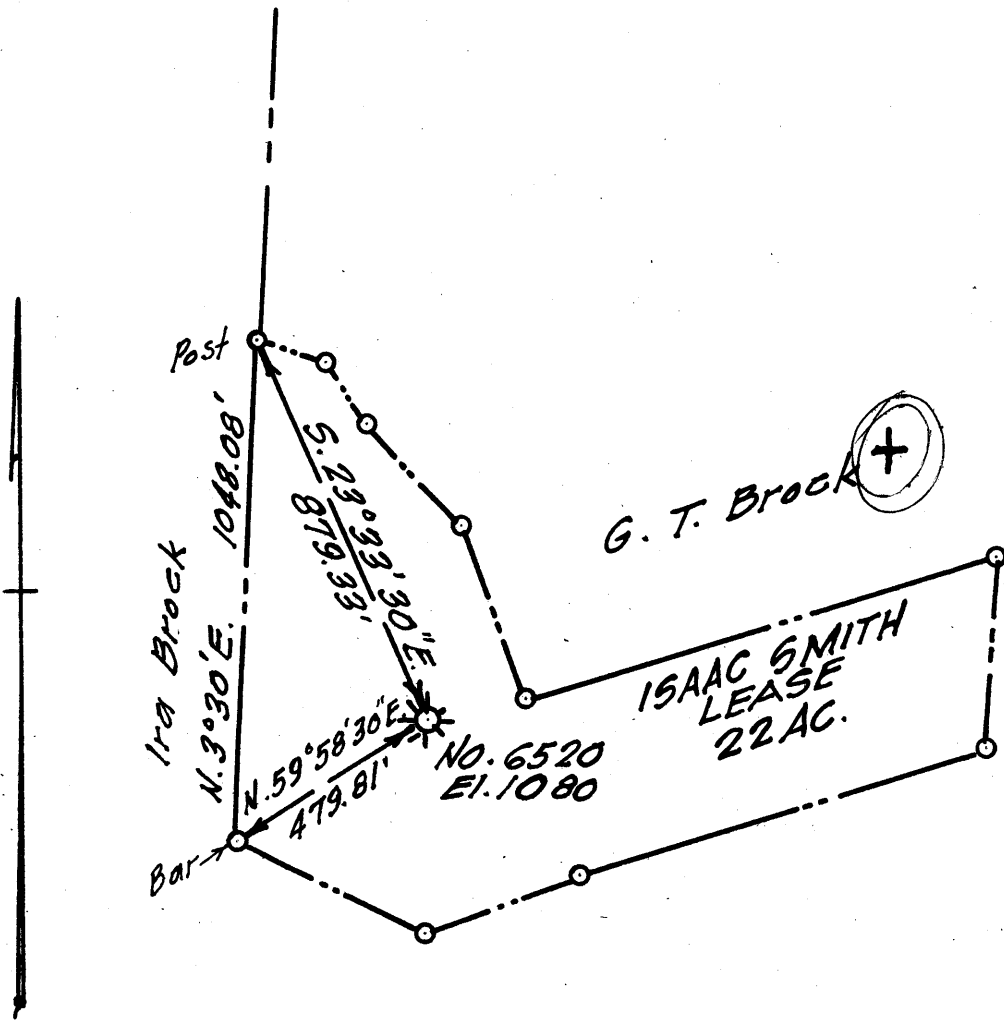

- New Location
- Drill Deeper
- Abandonment

AUG 7 1961

2.31
~~7.30~~ W
~~5.16~~ D
 5.16

Company A. M. SNIDER
 Address 60 Sunset Dr., Fairmont, W. Va.
 Farm Isaac Smith
 Tract _____ Acres 22 Lease No. _____
 Well (Farm) No. 6520 Serial No. _____
 Elevation (Spirit Level) EI. 1080
 Quadrangle Littleton
 County Netzel District Green
 Engineer Edmund H. Hefner
 Engineer's Registration No. 1868
 File No. A.M.S. Drawing No. 1
 Date April 5, 1958 Scale 1"=400'

STATE OF WEST VIRGINIA
 DEPARTMENT OF MINES
 OIL AND GAS DIVISION
 CHARLESTON

WELL LOCATION MAP
 FILE NO WET-1137-A

+ Denotes location of well on United States Topographic Maps, scale 1 to 62500, latitude and longitude lines being represented by border lines as shown.
 - Denotes one inch spaces on border line of original tracing.