


Latitude 39° 40'

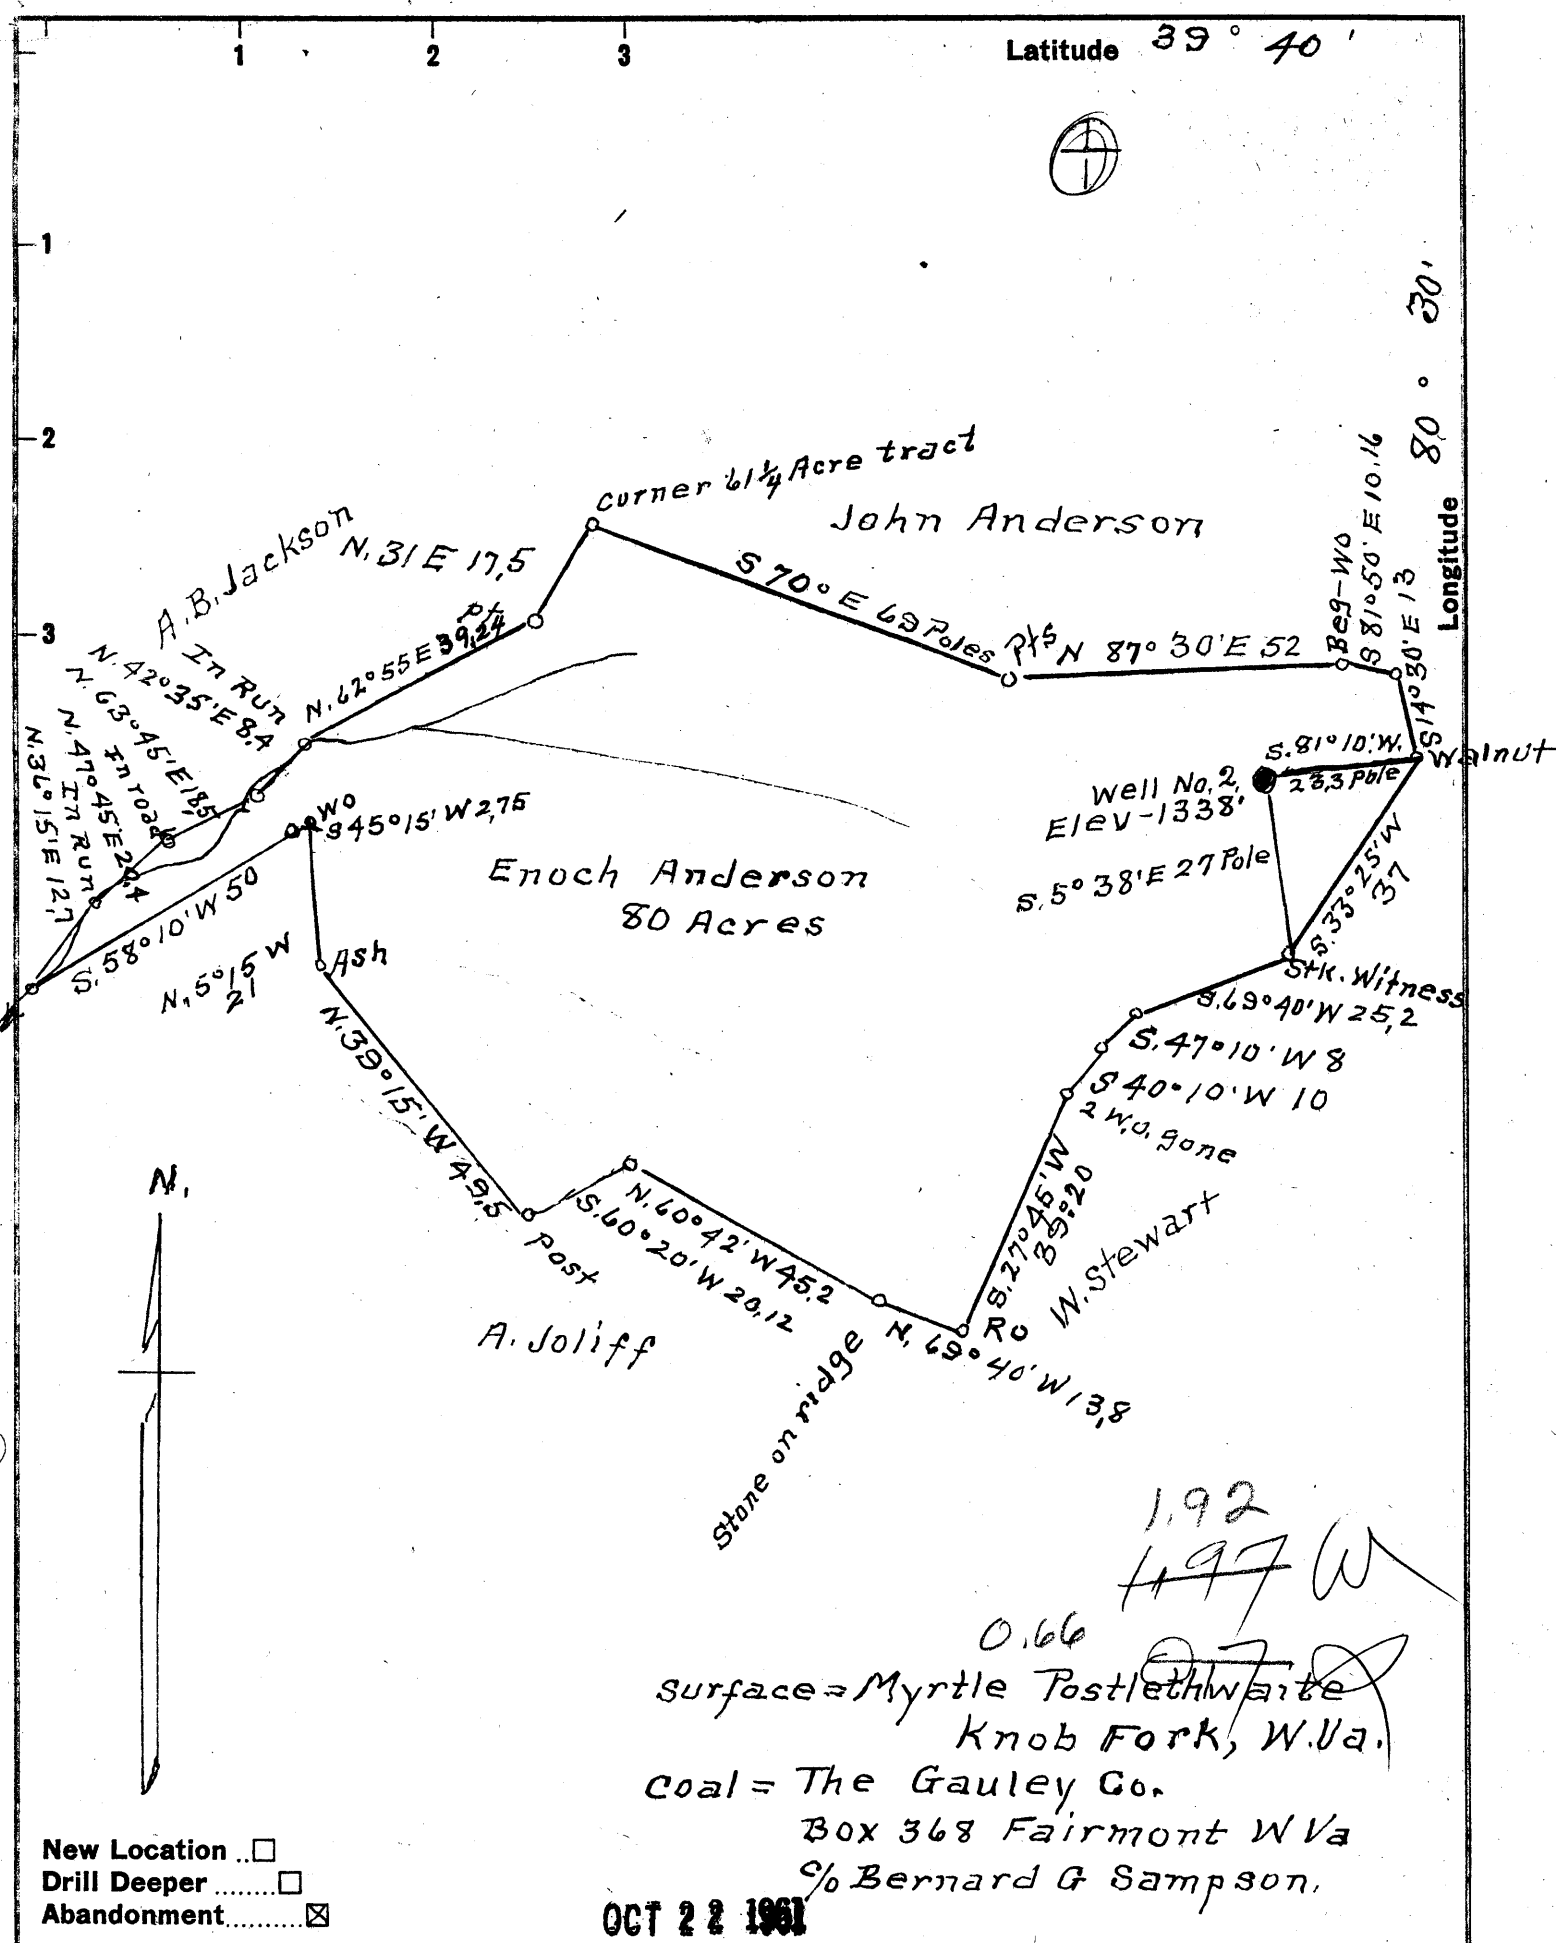

1.92
1.97 W
0.66
Surface = Myrtle Postlethwaite
Knob Fork, W. Va.
Coal = The Gauley Co.
Box 368 Fairmont W Va
c/o Bernard G Sampson.

New Location ..
Drill Deeper
Abandonment

OCT 22 1961

Company Bob Chisler
Address R. D. #2, Fairview W. Va
Farm Enoch Anderson
Tract 1 Acres 80 Lease No. _____
Well (Farm) No. 2 Serial No. _____
Elevation (Spirit Level) 1338'
Quadrangle Littleton
County Wetzel District Center
Engineer A. L. Headley
Engineer's Registration No. 2021
File No. _____ Drawing No. 1" = 500
Date 9-9-61 Scale 30 poles = 1 in

STATE OF WEST VIRGINIA
DEPARTMENT OF MINES
OIL AND GAS DIVISION
CHARLESTON

WELL LOCATION MAP
FILE NO. WET-1139-A

+ Denotes location of well on United States Topographic Maps, scale 1 to 62,500, latitude and longitude lines being represented by border lines as shown.

- Denotes one inch spaces on border line of original tracing.