


Latitude 39° 40'

"I, the undersigned, hereby certify that this map is correct to the best of my knowledge and belief and shows all the information required by paragraph 6 of the rules and regulations of the oil and gas section of the mining laws of West Virginia."

John B. Donley

Lizzie Martin

+ TOPO Loc.

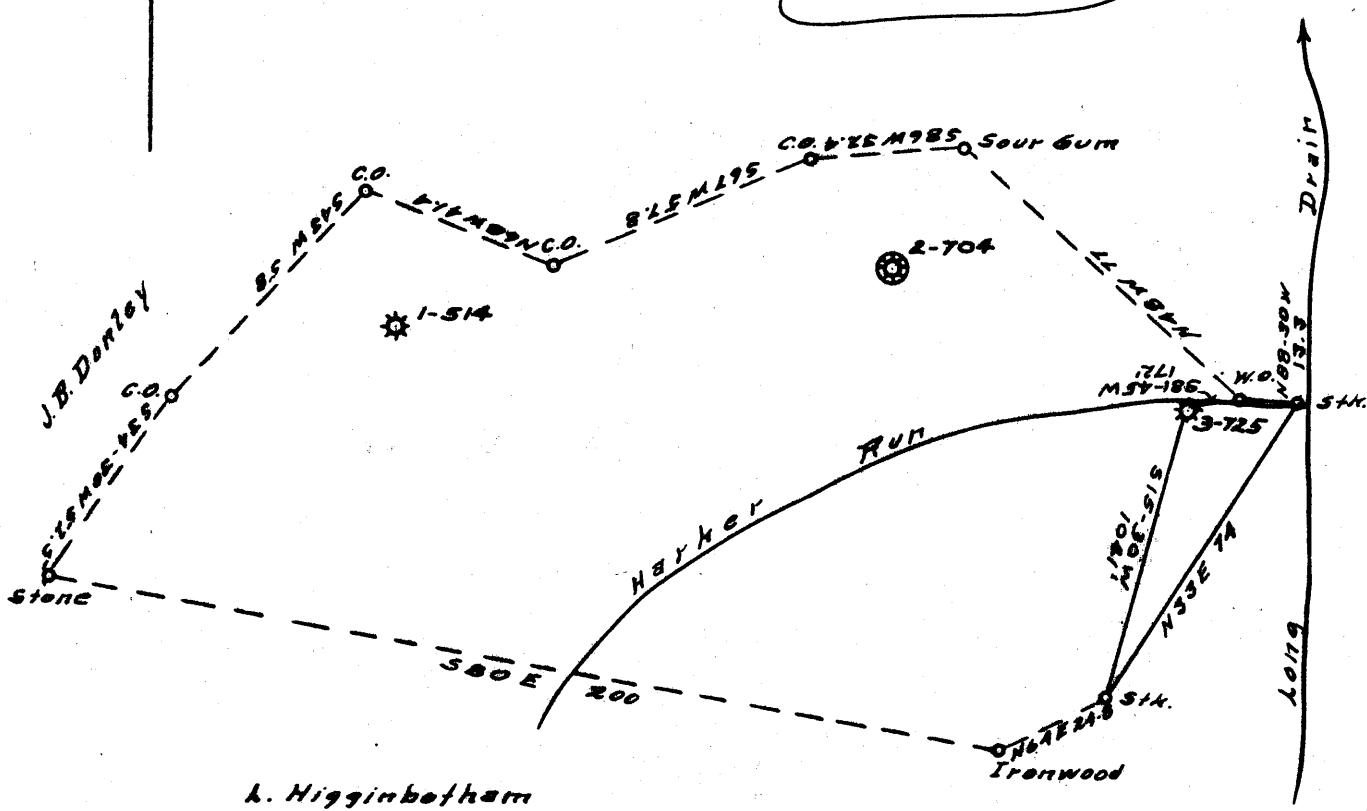

PEN COAST: Little Kanawha Syndicate
B.G. Sampson Engs. Fairmont, W.Va.

B.M.: Intersection of Roads in
EARNSHAW 1077'

Error in Closure: 1-250

New Location

Drill Deeper

Redrill

Abandonment

Company CARNEGIE NATURAL GAS
Address 3904 MAIN ST MUNNELL PA
Farm ROSETTA EARNSHAW
Tract Acres 12.9 Lease No. E 9050-72
Well (Farm) No. 3 Serial No. E 725
Elevation (Spirit Level) 1000' WG
Quadrangle MANNINGTON
County WETZEL District CHURCH
Engineer John B. Donley
Engineer's Registration No. 1850
File No. Drawing No.
Date 8-26-65 Scale 1:40,000 Miles = 660'

STATE OF WEST VIRGINIA
DEPARTMENT OF MINES
OIL AND GAS DIVISION
CHARLESTON

WELL LOCATION MAP

FILE NO. Wet-1184-A

+ Denotes location of well on United States Topographic Maps, scale 1 to 62,500, latitude and longitude lines being represented by border lines as shown.

— Denotes one inch spaces on border line of original tracing.