

39° 42' 30"

Latitude

80° 35' 00"

+
1.675
1.79w

Longitude

Topo Location

7.5' Loc. _____ 15' Loc. _____
(calc.) _____

Company Preston Oil Co

Farm C Yeater #1

15' Quad _____
(sec.) _____

7.5' Quad Littleton


District Center

WELL LOCATION PLAT

County 103 **Permit** 31224

LATITUDE 39° 45'

Longitude

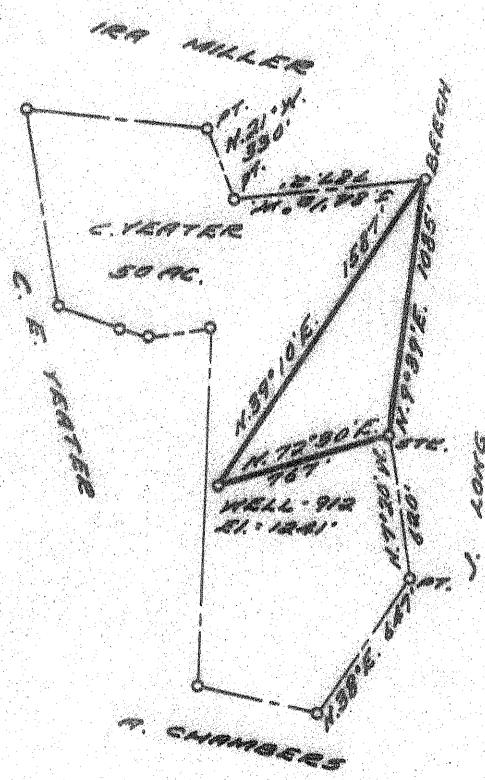

COAL OWNED BY CONSOLIDATION COAL CO.

- LOCATION
 RELOCATION
 DRILL DEEPER
 ABANDONMENT

"I, the undersigned, hereby certify that this map is correct to the best of my knowledge and belief and shows all the information required by paragraph 6 of the rules and regulations of the oil and gas section of the mining laws of West Virginia."

Minimum degree of accuracy is one part in 200.

Signed Robert McNeill

COMPANY	PRESTON OIL COMPANY		
ADDRESS	61 SOUTH ST., WASHINGTON, PA.		
FARM	C. VENTER		
MAP	1224-A	ACRES	107
WELL (PUMP) NO.	1	SERIAL NO.	912
EL ELEVATION (SPIRIT LEVEL)	1261'		
QUADRANGLE	LITTLETON NC		
COUNTY	MONTGOMERY		
POINT OF PUMP ELEVATION	ON BRIDGE		
FILE NO.	2406.1224		
DATE	OCT 23 1967		

STATE OF WEST VIRGINIA

DEPARTMENT OF MINES

OIL AND GAS DIVISION

CHARLESTON

WELL LOCATION MAP

FILE NO. WET-1224-A

+ DENOTES LOCATION OF WELL ON UNITED STATES TOPOGRAPHIC MAPS, SCALE 1:250,000. LATITUDE AND LONGITUDE LINES BEING REPRESENTED BY BORDER LINES AS SHOWN.

- DENOTES ONE INCH SPACES ON BORDER LINE OF ORIGINAL TRACING.

31224

Well No.

S. Yeates

Parry

STATE OF WEST VIRGINIA
AFFIDAVIT
TAYLOR PARRY AND WILSON STONEKING

STATE OF WEST VIRGINIA

County of Wetzel

Taylor Parry and Wilson Stoneking being first duly sworn according to law depose and say that they are experienced in the work of plugging and filling oil and gas wells and were employed by The Preston Oil Co well operator and participated in the work of plugging and filling the above well that said work was commenced on the 6 day of May 1969 and that the well was plugged and filled in the following manner

BAND OR BORE RECORD DESCRIPTION	FILLING MATERIAL	PLUG USED		CASING	
		PIPE & BAND	PULLED	PIPE	JOINT
Gordon Sand 3160-1178	Bridge 3178'-3000' 5' stone 10' cement, clay	Cement			
Injun Sand 23-7-2574	Bridge 2415'-2400 5' cement-10' clay	Cement		5"-1478	
Maxon Sand 2171-2270	Bridge 2270'-2000 clay	Cement		7"-1470	7
Salt sand	Bridge 2045-2000 clay	Cement		8"-1022	4
Little Dunkard	Bridge 1460- 5' stone, 10' Ce Clay- 1400' Bridge 1022	Cement			
	Set Vent pipe 5' stone 5' 5' clay, 20' cement, clay to surface	10"	492		0
COAL BLAND Pitt Coal	1122-1127	DESCRIPTION OF MONUMENT			
		4"x4" cement monument mark 6' above ground level.			

and that the work of plugging and filling the well was completed on the 30 day

May

RECEIVED
West Virginia
Department of Mines
27th day of June 1971

Taylor Parry
Wilson Stoneking

Sworn to and subscribed before me this 27th day of June

Woodrow W. Pyle
Notary Public

Permit No. N.W.P. 144ET

My commission expires

February 20, 1974