


39° 37' 30"

Latitude

80° 47' 30"

Longitude

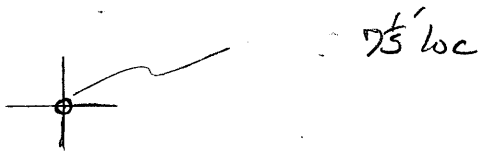

**Topo Location**

7.5' Loc.	<u>1.495</u>	15' Loc.	<u>4.375</u>
	<u>1.93W</u>	(calc.)	<u>4.15W</u>

Company Thomas Mills et al

Farm F.C. Wells #1

15' Quad Porters Falls  
(sec.) Newmartinsville

7.5' Quad EC

District Green Dist

**WELL LOCATION PLAT**

County 103 Permit 73499

W. VA. - WETZEL CO. - GREEN DIST.  
New Martinsville Quad. (Nmv 6-41)  
D.E.R. notes, p. 1319.

73499

103-73497

F. C. Wells No. 1 Well (188-3)(266A)

Green Dist., Wetzel Co., W. Va.; on east side of Little  
Fishing Creek 1.6 miles northwest of Minnie; completed  
(before 1886); by Thomas Mills, et al;  
Geo. Wolfe, driller; elevation, 635' B.

Big Injun Sand oil show; not drilled  
to Gordon; abandoned.