


Latitude 39° 10'

39° 07' 30" (7 1/2)

Longitude 81° 30'

~~5.80 S~~
~~5.72 S~~
~~2.18 W~~
 2.13 W
 6.50 (6.5)

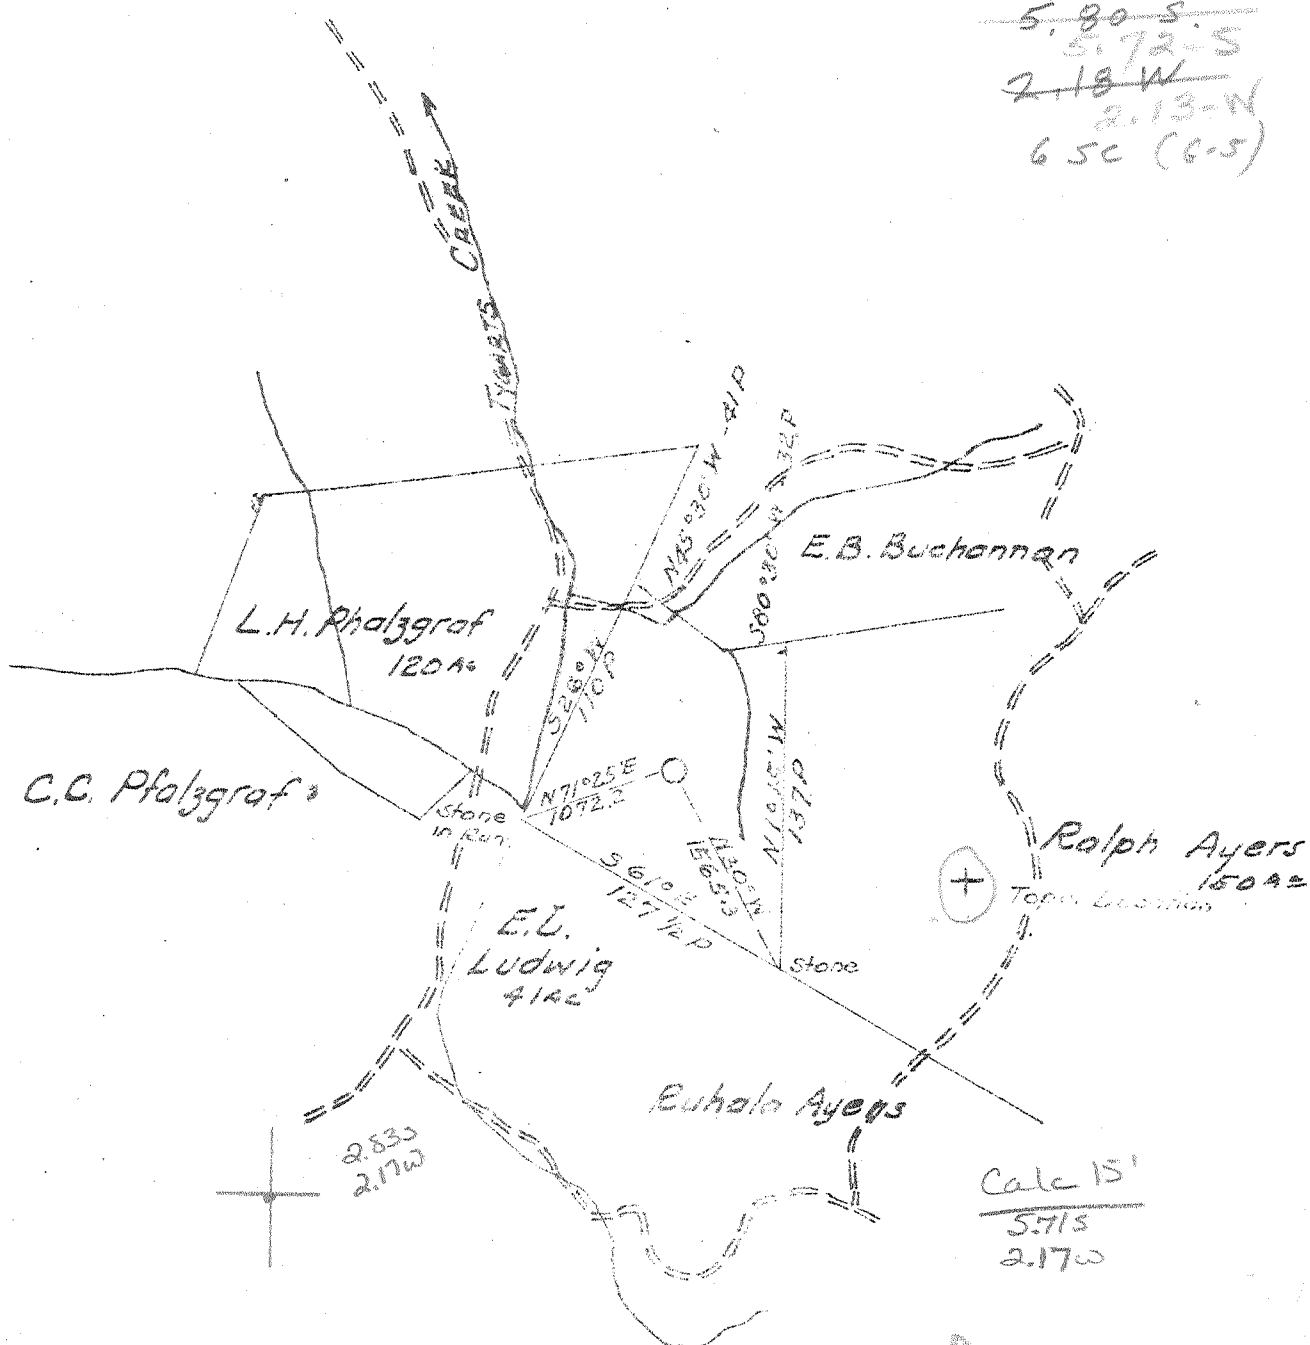

1/2" ROCKPORT

APP
 9/5/51

New Location
 Drill Deeper
 Abandonment

Company Godfrey W. Cabot Inc
 Address 300 Union Bldg Charleston W.Va.
 Farm D.E. Crow
 Tract _____ Acres 71 Deed Lease No. 2-148
 Well (Farm) No. 1 Serial No. 1329
 Elevation (Spirit Level) 854.80
 Quadrangle Belleville - **EC**
 County Wood District Steele
 Engineer _____
 Engineer's Registration No. _____
 File No. _____ Drawing No. _____
 Date 5-3-50 Scale 1" = 1320'

STATE OF WEST VIRGINIA
 DEPARTMENT OF MINES
 OIL AND GAS DIVISION
 CHARLESTON

WELL LOCATION MAP

FILE NO. W00-320-1

+ Denotes location of well on United States Topographic Maps, scale 1 to 62,500, latitude and longitude lines as represented by border lines as shown.

- Denotes one inch spaces on border of original tracing.

6-6-279

Deep Well

STATE OF W. VA. DEPT. OF MINES
OIL & GAS DIVISION
W E L L R E C O R D

Permit No. Woo-320
Belleville Quad.

Gas Well

Casing & Tubing

Company	Godfrey L. Cabot, Inc.	13"	270	270
Address	Charleston, W. Va.	10"	1487	1487
Farm	O. E. Crow	8"	2061	2061
Well No. 1	Elev. 855	7"	4917	4917
District	Steele County Wood			
Commenced	6/8/50			
Completed	9/7/50			
Shot	9/8/50 from 5016 to 5032.5			
	With 40 qts.			
Volume	622 c.c.f.			
Rock Pressure	1080 lbs. in 35 hrs.			

Red Rock	0	65	
Blue Slate	65	70	
Red Rock	70	120	
White Slate	120	180	
Red Rock	180	200	
White Slate	200	225	
Red Rock	225	350	
White Rock	350	377	
Red Rock	377	510	
Blue Slate	510	521	
Red Rock	521	530	
White Slate	530	550	
Red Rock	550	633	
White Slate	633	660	
Sand	660	680	
White Slate	680	710	
Sand	710	734	
White Slate	734	850	
Red Rock	850	945	
Slate & Shells	945	960	
Red Rock	960	967	
Slate & Shells	967	1000	
Red Rock	1000	1050	
Lime	1050	1076	
Sand	1076	1110	water 1095 1/2 bailer per hr.
Slate	1110	1172	
Sand	1172	1212	
Slate	1212	1224	
Sand	1224	1241	
Slate	1241	1280	
Sand	1280	1335	water 1300 2-13" bailer per hr.
Gray Slate	1335	1340	
Gritty Lime	1340	1390	
Sand	1390	1485	
Slate & Shells	1485	1610	
Sand	1610	1667	
Slate & Shells	1667	1680	
Black Lime	1680	1735	
Slate & Shells	1735	1736	
Sand	1736	1995	water 1775 hole filling up
Lime	1995	2150	
Slate & Shells	2150	3886	
Brown Shale	3886	4159	
Slate & Shells	4159	4580	
Brown Shale	4580	4896	
Corniferous Lime	4896	5017	
Oriskany	5017	5047	gas 5018 - 26 273 mcf.

4896 5017
855 855
4041 4162

Total Depth 5047

475