

P

Latitude 39° 15'

Longitude 81° 40'

2.83-5
~~2.86-S~~
~~1.78-W~~
1.75-W
3 C (G-5)



J. Whitlatch


Millard Abbott

Henry Greenburg
53 1/2 acres

T. J. Tack

Viola Reeder

New Eng.
1/2 mi.

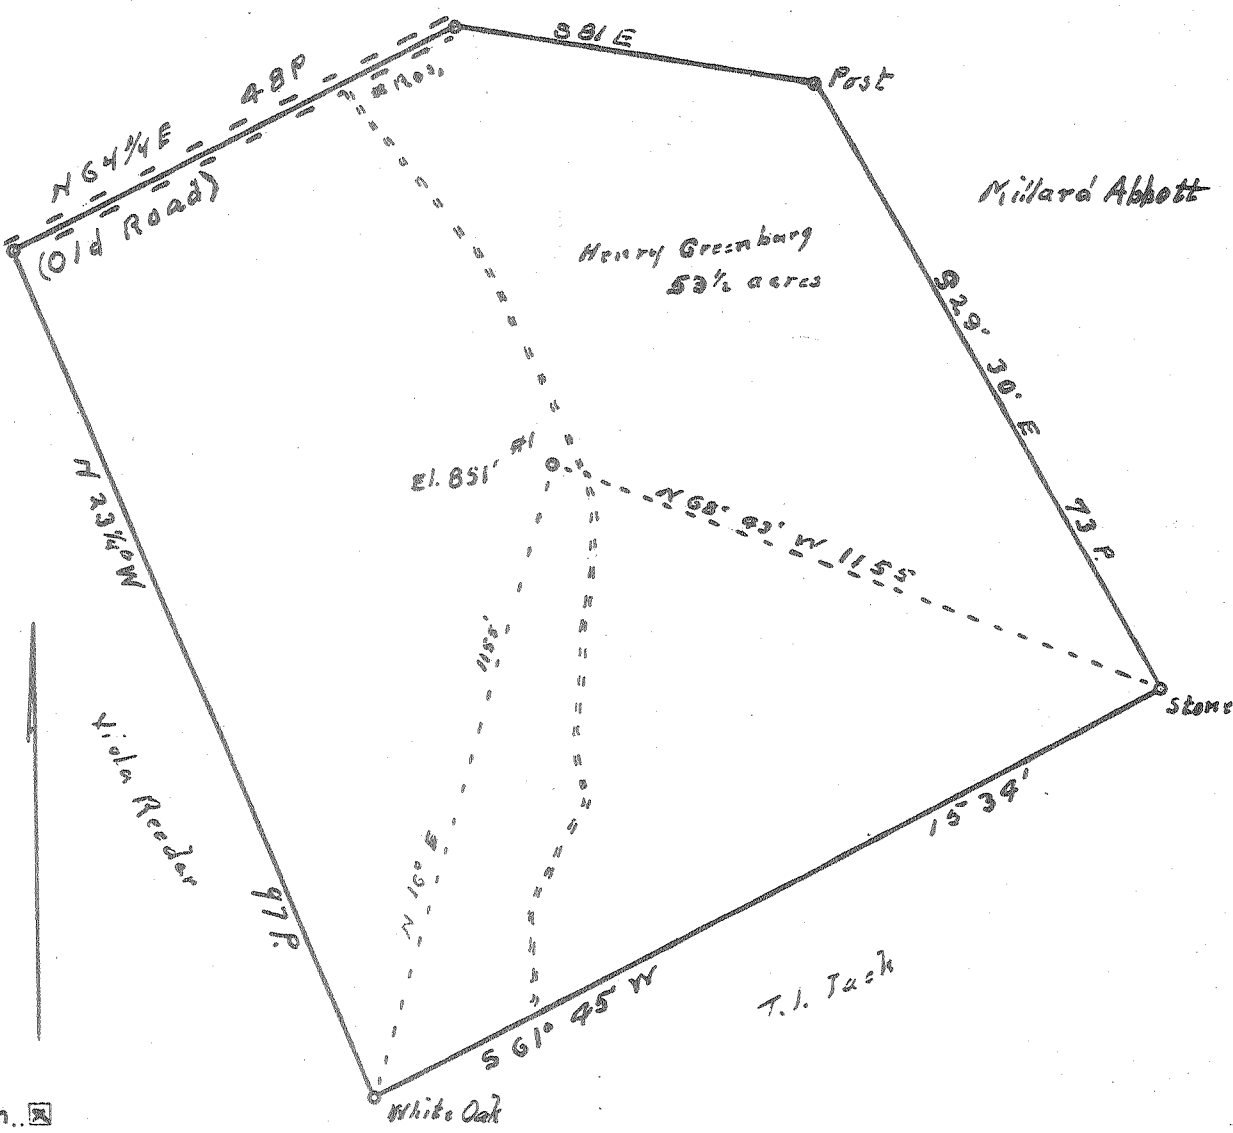

- New Location...
- Drill Deeper.....
- Abandonment.....

Company B. H. Putnam, Operator
 Address 1st Nat. Bank Marietta, Ohio
 Farm Henry Greenburg
 Tract _____ Acres 53 1/2 Lease No. _____
 Well (Farm) No. 1 Serial No. _____
 Elevation (Spirit Level) 851'
 Quadrangle Belleville (NW)
 County Wood District Harris
 Engineer Robert R. Anderson
 by O. Meredith
 Engineer's Registration No. 296
 File No. _____ Drawing No. _____
 Date 2/4 53 Scale 1 in = 20 Poles

STATE OF WEST VIRGINIA
 DEPARTMENT OF MINES
 OIL AND GAS DIVISION
 CHARLESTON

WELL LOCATION MAP
 FILE NO. W00-384

+ Denotes location of well on United States Topographic Maps, scale 1 to 62,500, latitude and longitude lines being represented by border lines as shown.

- Denotes one inch spaces on border line of original tracing.

676-296 Deepwell



STATE OF WEST VIRGINIA
DEPARTMENT OF MINES
OIL AND GAS DIVISION 5

Beleville

WELL RECORD

Permit No. *Woo-384*

Oil or Gas Well Gas
(KIND)


Company B. H. Putnam, Operator
Address 512 Third Street, Marietta, Ohio
Farm H. M. Greenburg Acres 54
Location (waters) _____
Well No. 1 Elev. 851
District Harris County Wood
The surface of tract is owned in fee by H. M. Greenburg
New England Address West Virginia
Mineral rights are owned by H. M. Greenburg
Address _____
Drilling commenced February 11, 1953
Drilling completed April 2, 1953
Date Shot Hydrafrac From _____ To _____
With _____
Open Flow _____ /10ths Water in _____ Inch
_____ /10ths Merc. in _____ Inch
Volume 1,650,000 Cu. Ft.
Rock Pressure 1560 lbs. _____ hrs.
Oil none bbls., 1st 24 hrs.
Fresh water none feet _____ feet
Salt water none feet _____ feet

Casing and Tubing	Used in Drilling	Left in Well	Packers
Size			Kind of Packer
16			Baker Model 'K'
13			Size of
10	385		Depth set 4380
8 3/4	1000		Perf. top
6 3/4	1780	1780	Perf. bottom
5 3/16	4358	4358	Perf. top
3			Perf. bottom
2			
Liners Used			

CASING CEMENTED 5-1/2 SIZE 4358 No. Ft. 3/21/53 Date

COAL WAS ENCOUNTERED AT _____ FEET _____ INCHES
_____ FEET _____ INCHES FEET _____ INCHES
_____ FEET _____ INCHES FEET _____ INCHES

Formation	Color	Hard or Soft	Top	Bottom	Oil, Gas or Water	Depth Found	Remarks
Surface			0	8			
Rock	Red		8	215			
Sand			215	230			
Broken sand			230	260			
Sand			260	305			
Rock	Red		305	340			
Sand			340	370			
Slate			370	442			
Lime			442	458			
Slate & shells			458	508			
Rock	Red		508	520			
Slate	Gray		520	545			
Sand			545	560			
Slate			560	665			
Rock	Pink		665	685			
Sand			685	725			
Rock	Red		725	765			
Lime			765	782			
Rock	Red		782	885			
Slate			885	937			
Sand			937	955			
Slate			955	970			
Rock	Red		970	995			
Sand			995	1020			
Slate			1020	1285			
Sand			1285	1343			
Slate			1343	1360			
Sand			1360	1500			
Slate			1500	1585			
Sand			1585	1775			
Slate			1775	2053			
Slate	Black	<i>Copper Sh.</i>	2053	2082			
Sand			2082	2086			
Shells			2086	2500			

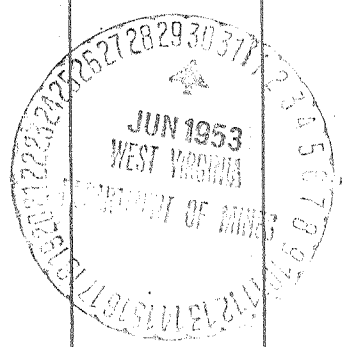

Formation	Color	Hard or Soft	Top	Bottom	Oil, Gas or Water	Depth Found	Remarks
Slate	Cinnamon Dark		2500	3245			
Slate			3245	4095			
Shale			4095	4268			
Cornif. Lime			4268	4361			
Osiskany			4361	4390			
				475			

Date _____, 19__

APPROVED _____, Owner