
Plot _ Gard CSD /0 5-7	P-PD
	Latitude 39° 20′ 00″  6650' SOUTH  9620' WEST  00
CORBIN OSTOSED	Longitude
HOLLIDAY	MIRACLE
	on GORDON Oil
Drill Deeper Source of Elevation I, the undersigned, he Redrill and belief and shows	Cas Other  ROAD ON PUMPKIN KNOB (893')  Pereby certify that this map is correct to the best of my knowledge all the information required by paragraph 6 of the rules and and gas section of the mining laws of West Management
Company BEREA OIL & GAS CORPORATION  Address BUFFALO, NY  Surface Owner LUTHER WINGROVE  Mineral Owner " "	STATE OF WEST WIGHTS:  DEPARTMENT OF MINES.  OIL AND GAS DISEN  CHARLESTON  WELL LOCATION MAP
Well No. 1 Acres 76-1/2  Elevation 883' MARIETTA 15'  Quadrangle WILLOW ISLAND Series 7.5'  County WOOD District UNION  Date 4/25/80 Scale 1" = 500'	Topographic Maps. Engineer's Registration No. 3788 File No. 80-258

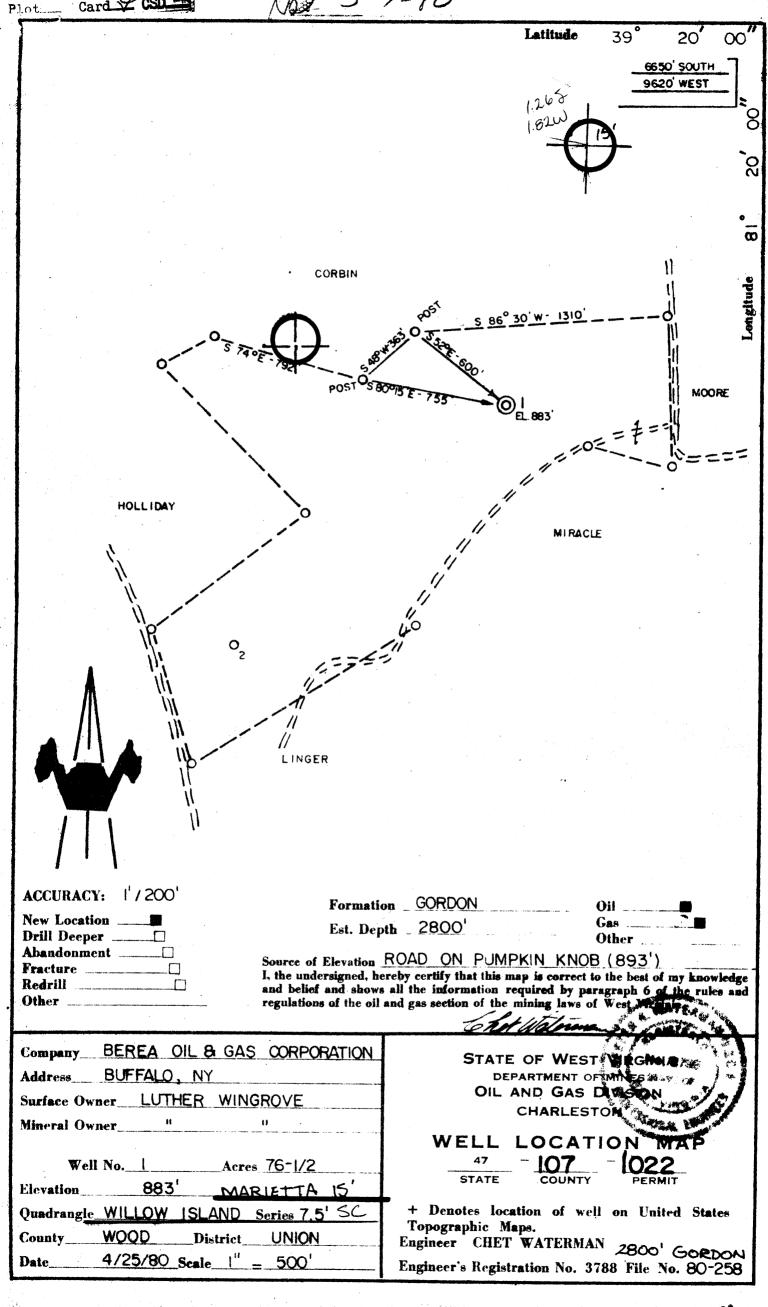



APR 3 0 1980

## DEPARTMENT OF MINES

OIL & GAS DIVISION

## Oil and Gas Division DEPT. OF MINES

## OIL AND GAS WELL PERMIT APPLICATION

						• .
TO THE DEPARTMENT OF MINES,		_		1000	-	
Charleston, W. Va.		DATEApril 30, 1980				
Surface Owner Luther B. Wingro	ve	Company Berea Oil & Gas Corp.				
Address Rt. # 2, Waverly, W. Va.		Address	See well	operator	below	····
Mineral Owner same		Farm W	ingrove		Acres	76½
Address	*	Location (w	vaters) Bull	Run		
Coal Owner same	1	Well No	# 1		_ Elevation	883
Address		DistrictU	nion		County_	Wood
Coal Operator same		Quadrangle	Willow	[sland		
Address						
THE WELL SITE			,			
chapter 22,						
a to the incomon is not a		PECTOR				
day 11 day	TO F	BE NOTIFI	[ED <u>Paul (</u>	300dnight	•	
no have not commenced by 1-13-81	ADDA	RESS Smit	hville, W	Va		
no have not confirm		Dille	41V 11110 J 11	<u> </u>		•
Flort A Sil & Gas Division	PHON	IE <u>304-47</u>	77-3660		-;	
buty Director - Oil & Gas Division GENTLEMEN:		•••				
The undersigned well operator is entitled to	drill upon the ab	ove named	farm or tract	of land for	oil and gar	s, having fe
title thereto, (or as the case may be) under g	=					
Wingrove made to Energy U						
19_80 in Wood County, Boo					·	
		_				
XX NEW WELLDRILL				FRACTU	RE OR SI	'IMULATE
OIL AND GAS WELL ORIGINA	LLY DRILLED BI	EFORE JUI	NE 5, 1969.	.*		
The enclosed plat was prepared by a registe	ered engineer or li	censed land	surveyor an	d all coal o	wners and/c	or operator
have been notified as of the above date.						
. The above named coal owners and/or opera-	tor are hereby noti	fied that ar	ny objection	they wish to	make, or	are require
to make by Section 3 of the Code, must be re	ceived by, or filed	with the D	epartment of	Mines with	in ten (10)	days. *
Copies of this notice and the enclosed plat		istered mail	, or delivered	to the above	e named co	al operator
or coal owners at their above shown respectives me day with the mailing or delivery of this c	e address	ment of Mi	day nes at Charles	ston, West V	belore, Irginia.	or on the
and day with the haming of domes, or the						
PLEASE SUBMIT COPIES OF ALL	Ver	y truly you	Mark Scl		e regim "s	:
GEOPHYSICAL LOGS DIRECTLY TO:	(Sig	n Name)	my	chur	eher	
			652 Emp	ire Bank	_	·
VEST VIRGINIA GEOLOGICAL AND			Fourth	& Main St	reets	
CONOMIC SURVEY	Address of			Street		
P. O. BOX 879 MORGANTOWN, WEST VIRGINIA 26505	Well Operator		Clarksb	irg,		
AC-304 - 292-6331	<del>.</del> .		City	or Town		. ~. •
	·		W. Va.			05.7713
en e	·			State		
*SECTION 3 If no objections are filed o			nes, within said	period of te	n days from	the receipt
notice and plat by the department of mines; to said p he filing of such plat, that no objections have been ma	roposed location, the	department si	hall forthwith is	sue to the we	ll operator a	permit reciti
and the well operator authorized to proceed.				•		
RI ANKET ROMO			47–107-	-1022		

"I have read and understand the reclamation requirements as set forth in Chapter 22, Article 4, Section 12-b and will carry out the specified requirements."

Signed by

## THIS IS AN ESTIMATE ONLY . ACTUAL INFORMATION WILL BE SUBMITTED ON OG-10 UPON COMPLETION

PROPOSED WORK ORDER	TO XX DRILL	DEEPEN	FRACTURE-STIMULATE				
DRILLING CONTRACTOR:	·		RESPONSIBLE AGENT:				
			NAME Mark Schumacher				
ADDRESS			ADDRESS Clarksburg, W. Va.				
TELEPHONE			TELEPHONE 304-624-6429				
ESTIMATED DEPTH OF CO	MPLETED WELL: 2800'	ROTARY XX	ROTARY XX CABLE TOOLS				
PROPOSED GEOLOGICAL F	ORMATION:Gordon	-					
TYPE OF WELL: O	L X GAS X	COMB. X STORAG	E DISPOSAL				
	RECYC	LING WATER FL	OODOTHER				
TENTATIVE CASING PROGI	RAM:		•				
CASING AND TUBING SIZE	USED FOR DRILLING	LEFT IN WELL	CEMENT FILL UP OR SACKS - CUBIC FT.				
20 - 16							
13 - 10							
9 - 5/8							
8 - 5/8 XX	^250'	250 <b>'</b>	Surface				
<del>7</del> 5 ½	,						
4 ½ XX	T. D.	T. D.	400'				
3			Perf. Top				
2			Perf. Bottom				
Liners			Perf. Top				
			Perf. Bottom				
OF PLAT.  TO DRILL DEEPER OR RED		WII FEE, FERFORMANCE	BOND AND PERMANENT COPY				
SUBMIT FIVE (5) COPIL	ES OF OG - 1, SHOWING ORIG R TO 1929, A PERMANENT		ND PERFORMANCE BOND. ON THE ORIGINAL WELL RECORD				
TO FRACTURE - STIMULATI	?•	•					
OIL AND/OR GAS WELI		ORE JUNE 5, 1929, FIVE (5)	COPIES OG - 1, PERFORMANCE				
OIL AND/OR GAS WELI		AND/OR AFTER JUNE 5, 19	29, FIVE COPIES OG - 1, SHOW-				
Required forms must be four (24) hours in advance		completion for bond release.	Inspector to be notified twenty-				
· · · · · ·		<b>.</b> 777					
	•	. ·	•••				
The following waiver mu thereof.	st be completed by the coal o	perator if the permit is to be	issued within ten days of receipt				
WAIVER: I the undersigned.	Agent for	Coal Company Owns	er or Operator of the coal under				
	nined and place on our mine						
			well being drilled at this location,				
providing operator h			7, Chapter 22 of the West Virginia				
Code.		grande de la Servicia del Servicia de la Servicia del Servicia de la Servicia del Servicia de la Servicia del Servicia de la Servicia dela Servicia del Servicia del Servicia de la Servicia del Servicia dela Servicia dela Servicia del Servicia dela Servicia del	and the second of the second o				
_	•		For Coal Company				