

WW-7
8-30-06



West Virginia Department of Environmental Protection
Office of Oil and Gas
WELL LOCATION FORM: GPS

API: 4701700026 WELL NO.: 1473

FARM NAME: Leeman Maxwell

RESPONSIBLE PARTY NAME: Justin L. Henderson

COUNTY: Doddridge DISTRICT: South West

QUADRANGLE: Oxford

SURFACE OWNER: Justin L. Henderson

ROYALTY OWNER: Justin L. Henderson

UTM GPS NORTHING: 4340150.6

UTM GPS EASTING: 5203846 GPS ELEVATION: 1010

The Responsible Party named above has chosen to submit GPS coordinates in lieu of preparing a new well location plat for a plugging permit or assigned API number on the above well. The Office of Oil and Gas will not accept GPS coordinates that do not meet the following requirements:

1. Datum: NAD 1983, Zone: 17 North, Coordinate Units: meters, Altitude: height above mean sea level (MSL) – meters.
2. Accuracy to Datum – 3.05 meters
3. Data Collection Method:

Survey grade GPS : Post Processed Differential
Real-Time Differential

Mapping Grade GPS : Post Processed Differential
Real-Time Differential


4. Letter size copy of the topography map showing the well location.

I the undersigned, hereby certify this data is correct to the best of my knowledge and belief and shows all the information required by law and the regulations issued and prescribed by the Office of Oil and Gas.

Justin L. Henderson
Signature

Title

11/30/2016
Date

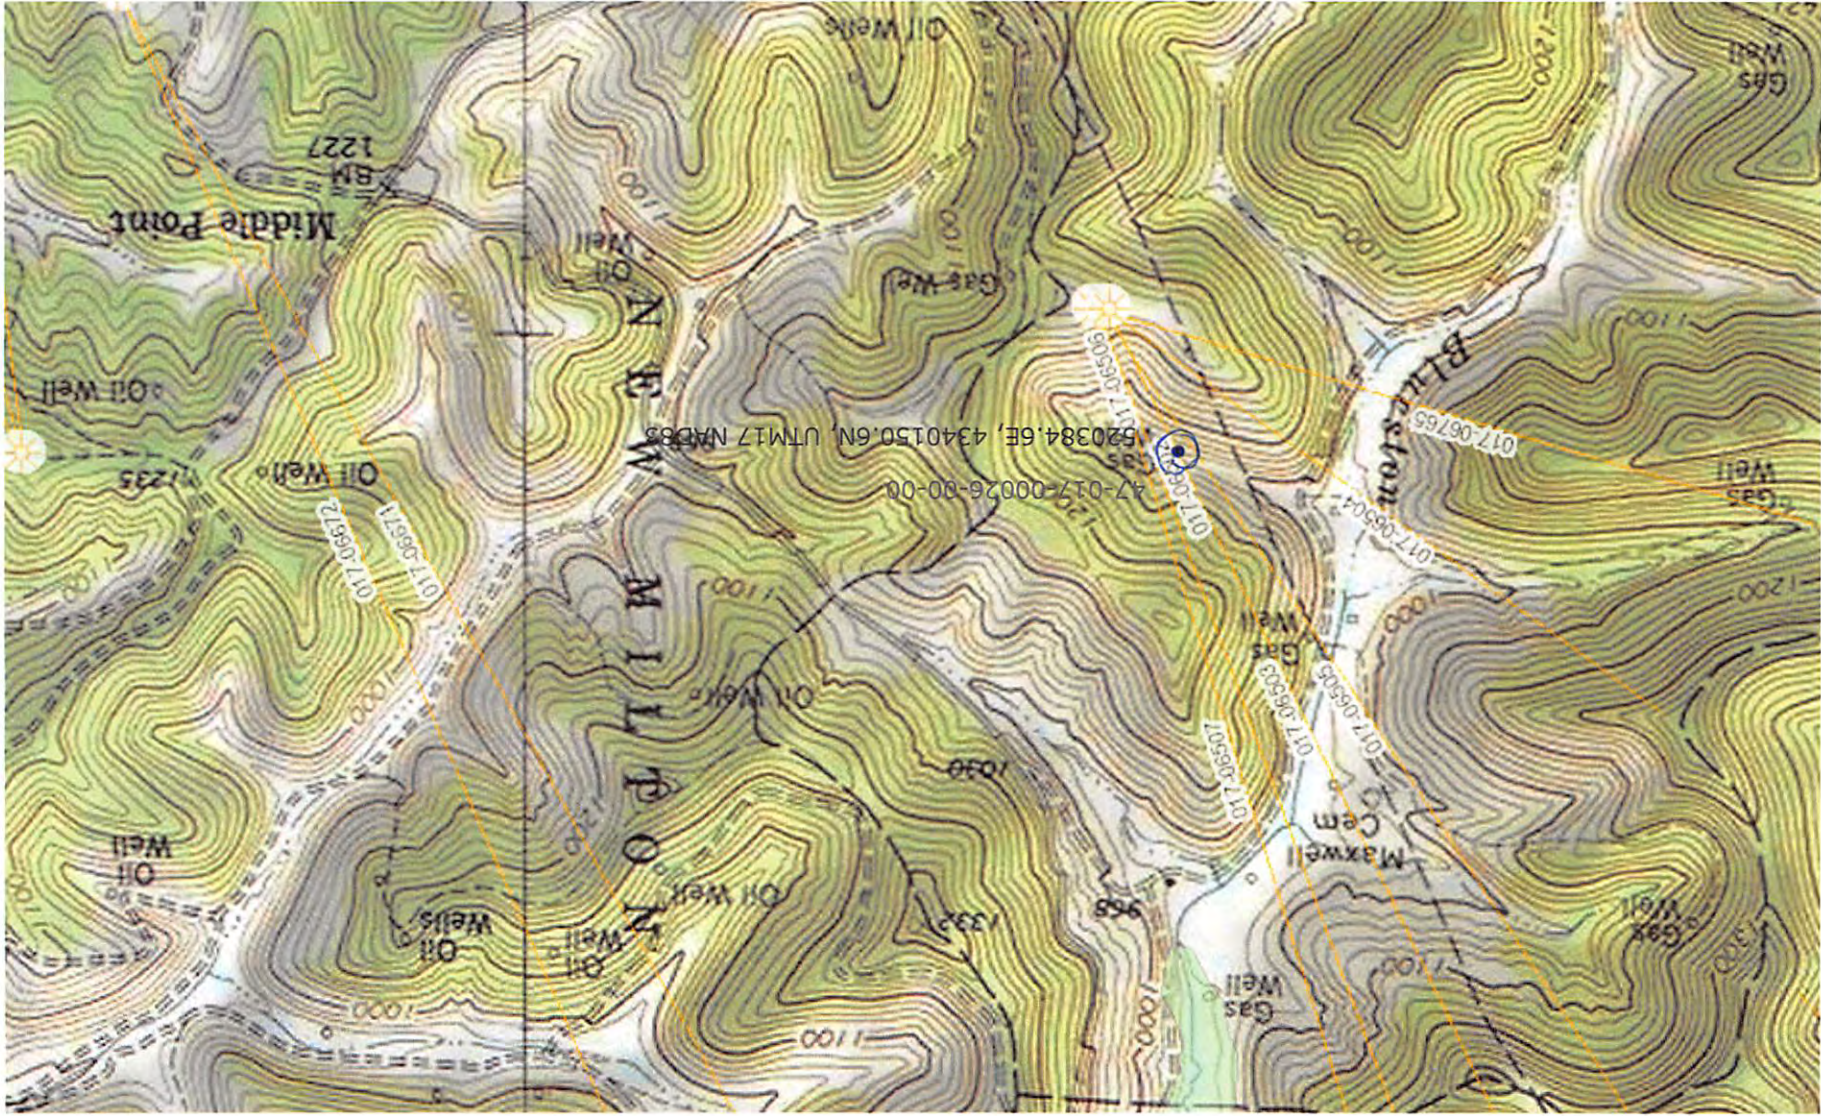

1700026P