Latitude 38° 15'

Longitude 80°45'

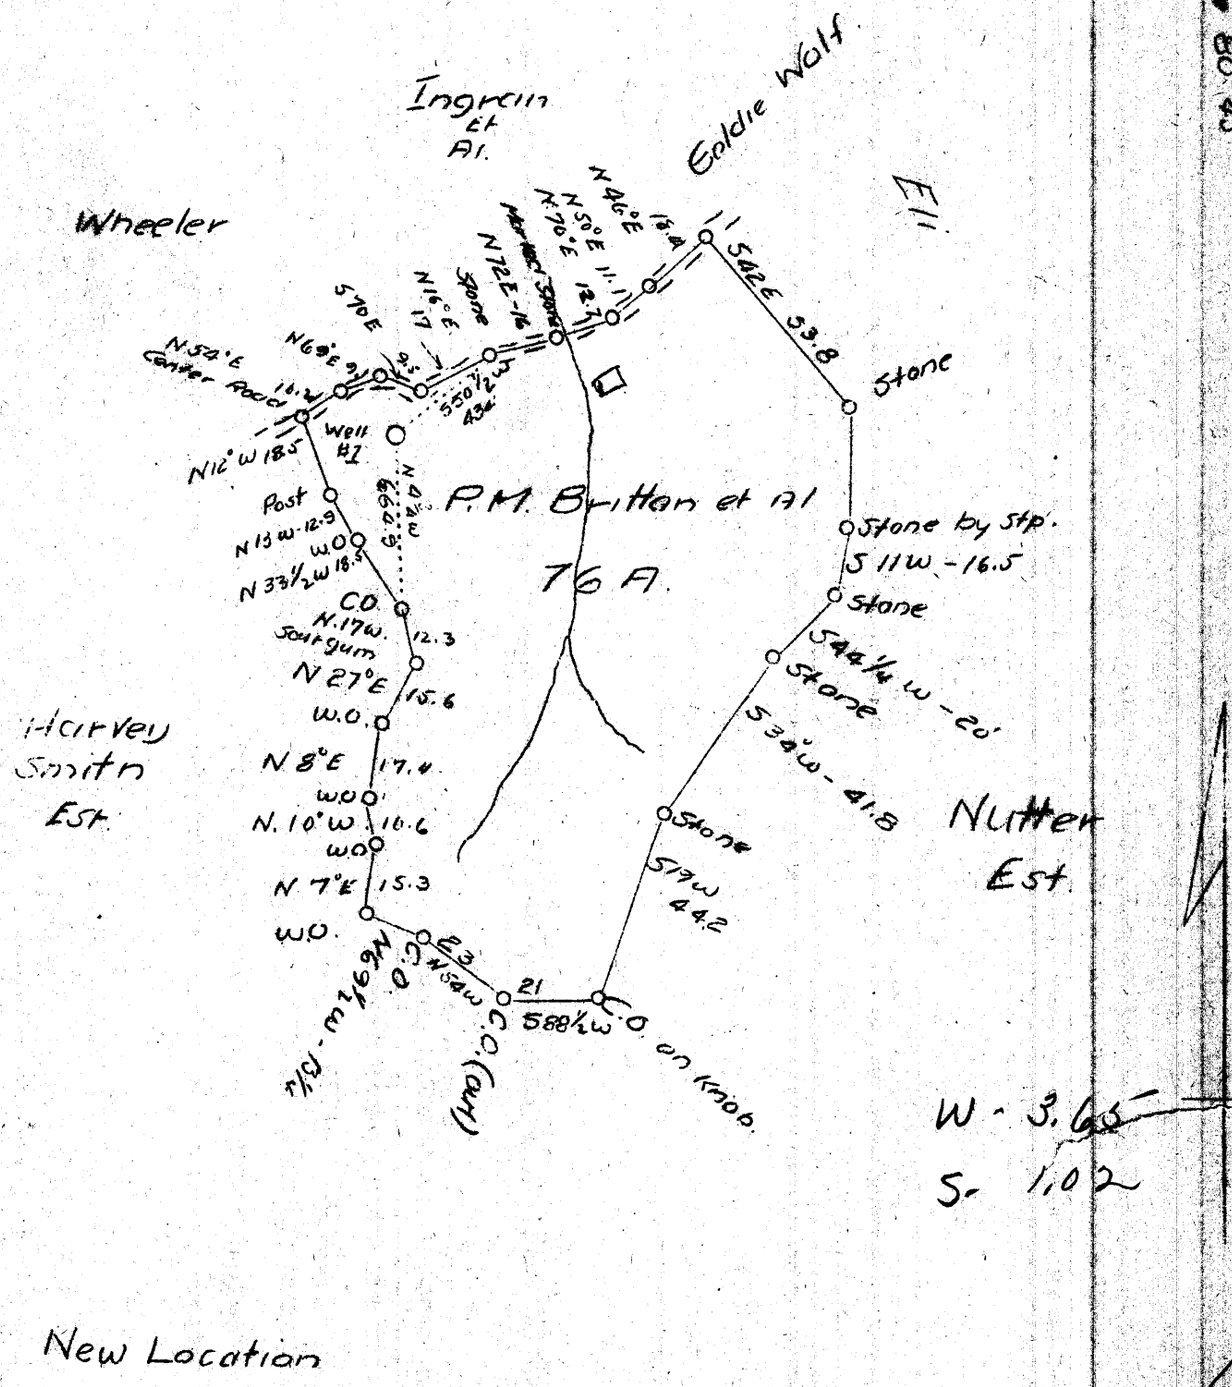

New Location

Company	W. Claud Maxwell
Address	West Union, W. Va.
Farm	P. M. Britton, et al
Tract	1
Acres	76
Well (Farm) No.	1
Elevation (SL)	1057
Quadrangle	Holbrook N.E. (Oxford 7½)
County	Doddridge
District	West Union
Engineer	J. M. Martin
Eng. Reg. No.	84
Date	Sept. 23, 1939
Scale	40 poles - 1"

STATE OF WEST VIRGINIA
Department of Mines
OIL & GAS DIVISION
Charleston

WELL LOCATION MAP

File No. Dod 105

x Denotes location of well on U. S. Topographic Maps, scale 1 to 62,500, latitude and longitude lines being represented by border lines as shown.

- Denotes one inch spaces on border line of original tracing.