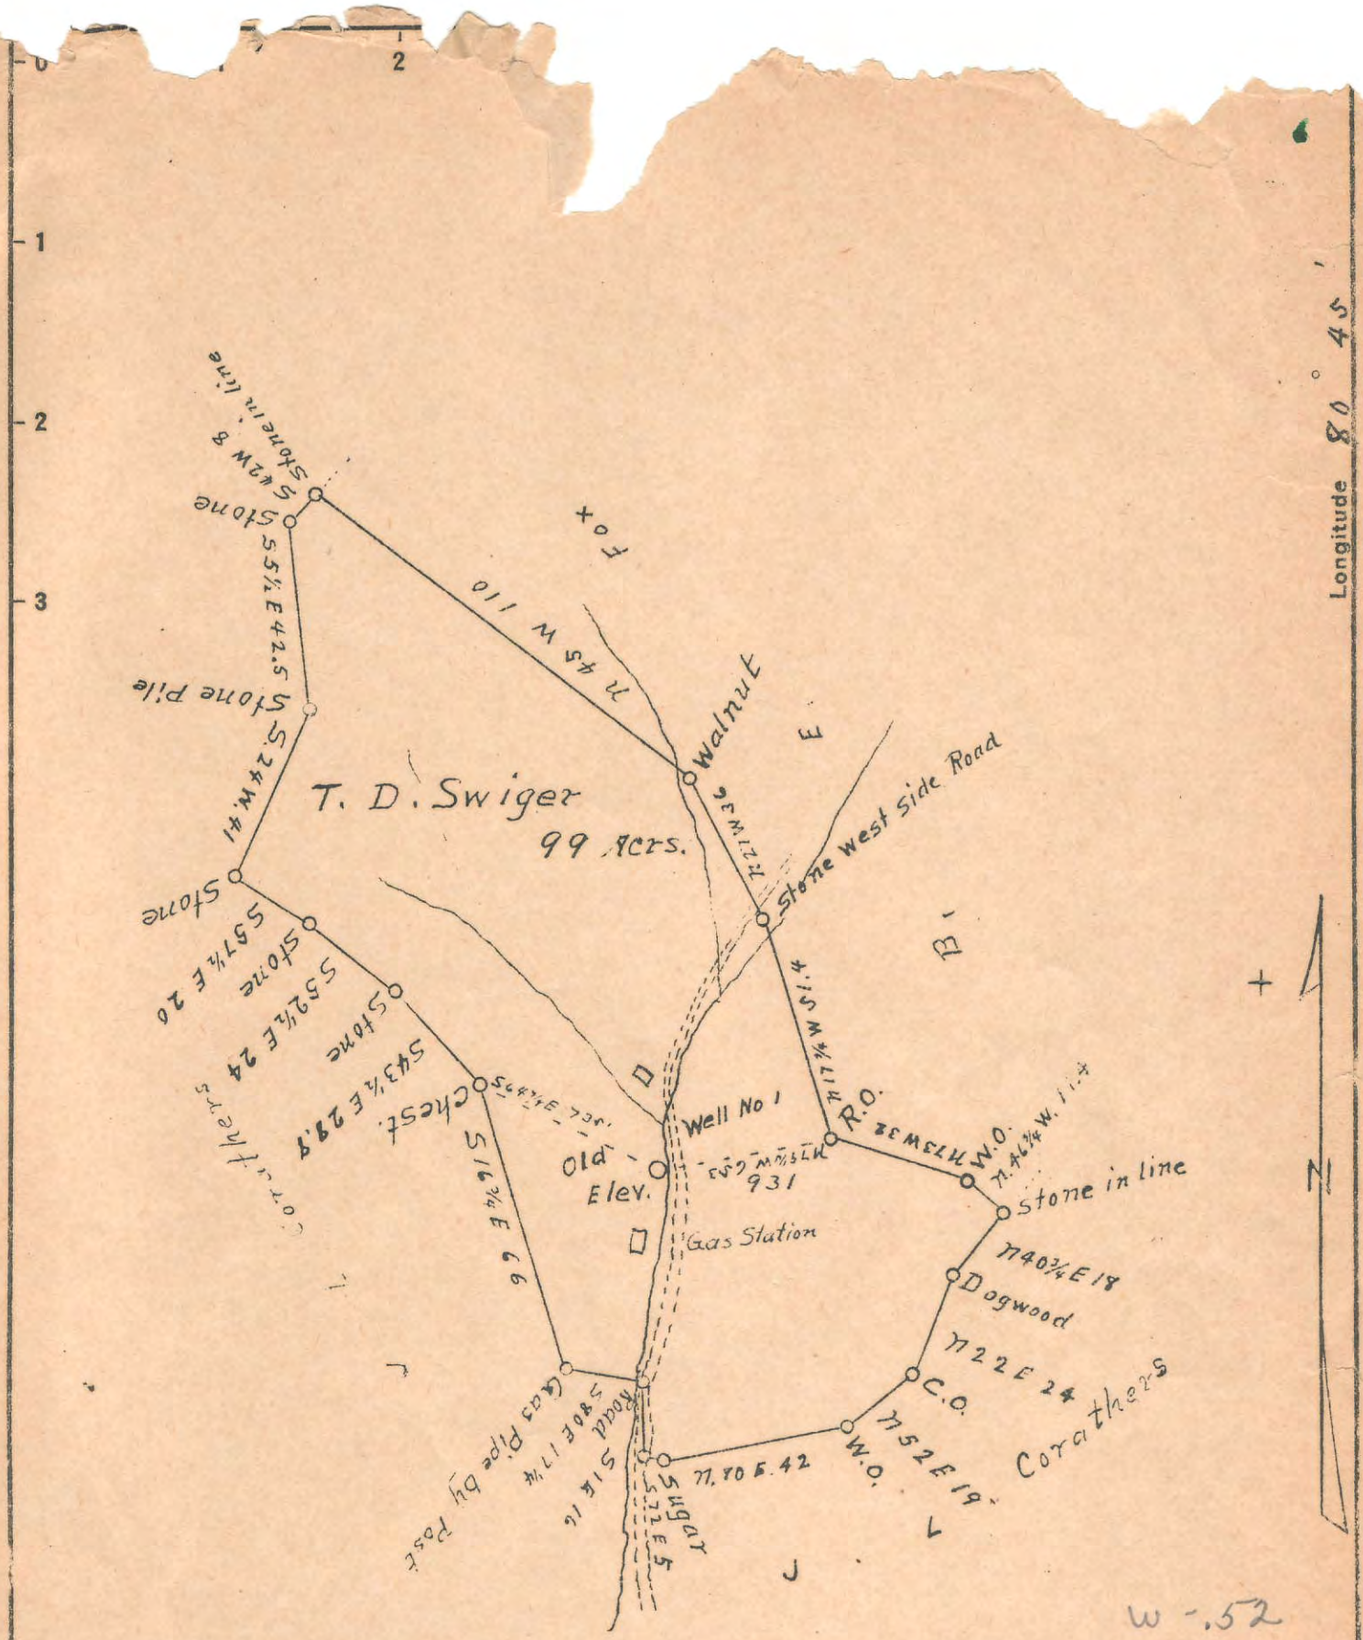

New Location ☐
Drill Deeper ☒
Abandonment ☐

Company Braden & Creighton
Address Marietta Ohio.
Farm T. D. Swiger.
Tract one Acres 99 Lease No.
Well (Farm) No. 1 Serial No.
Elevation (Spirit Level) 931
Quadrangle West Union. EC
County Doddridge District West Union
Engineer J. M. Martin
Engineer's Registration No. 8-1
File No. Drawing No.
Date March 4. 1941 Scale 40 P - 1 inch

STATE OF WEST VIRGINIA
DEPARTMENT OF MINES
OIL AND GAS DIVISION
CHARLESTON

WELL LOCATION MAP

FILE NO. DOD-113

+ Denotes location of well on United States Topographic Maps, scale 1 to 62,500, latitude and longitude lines being represented by border lines as shown.

— Denotes one inch spaces on border line of original tracing.

PRINTED ON "IMPERIAL" TRACING CLOTH KAFCO N.Y.