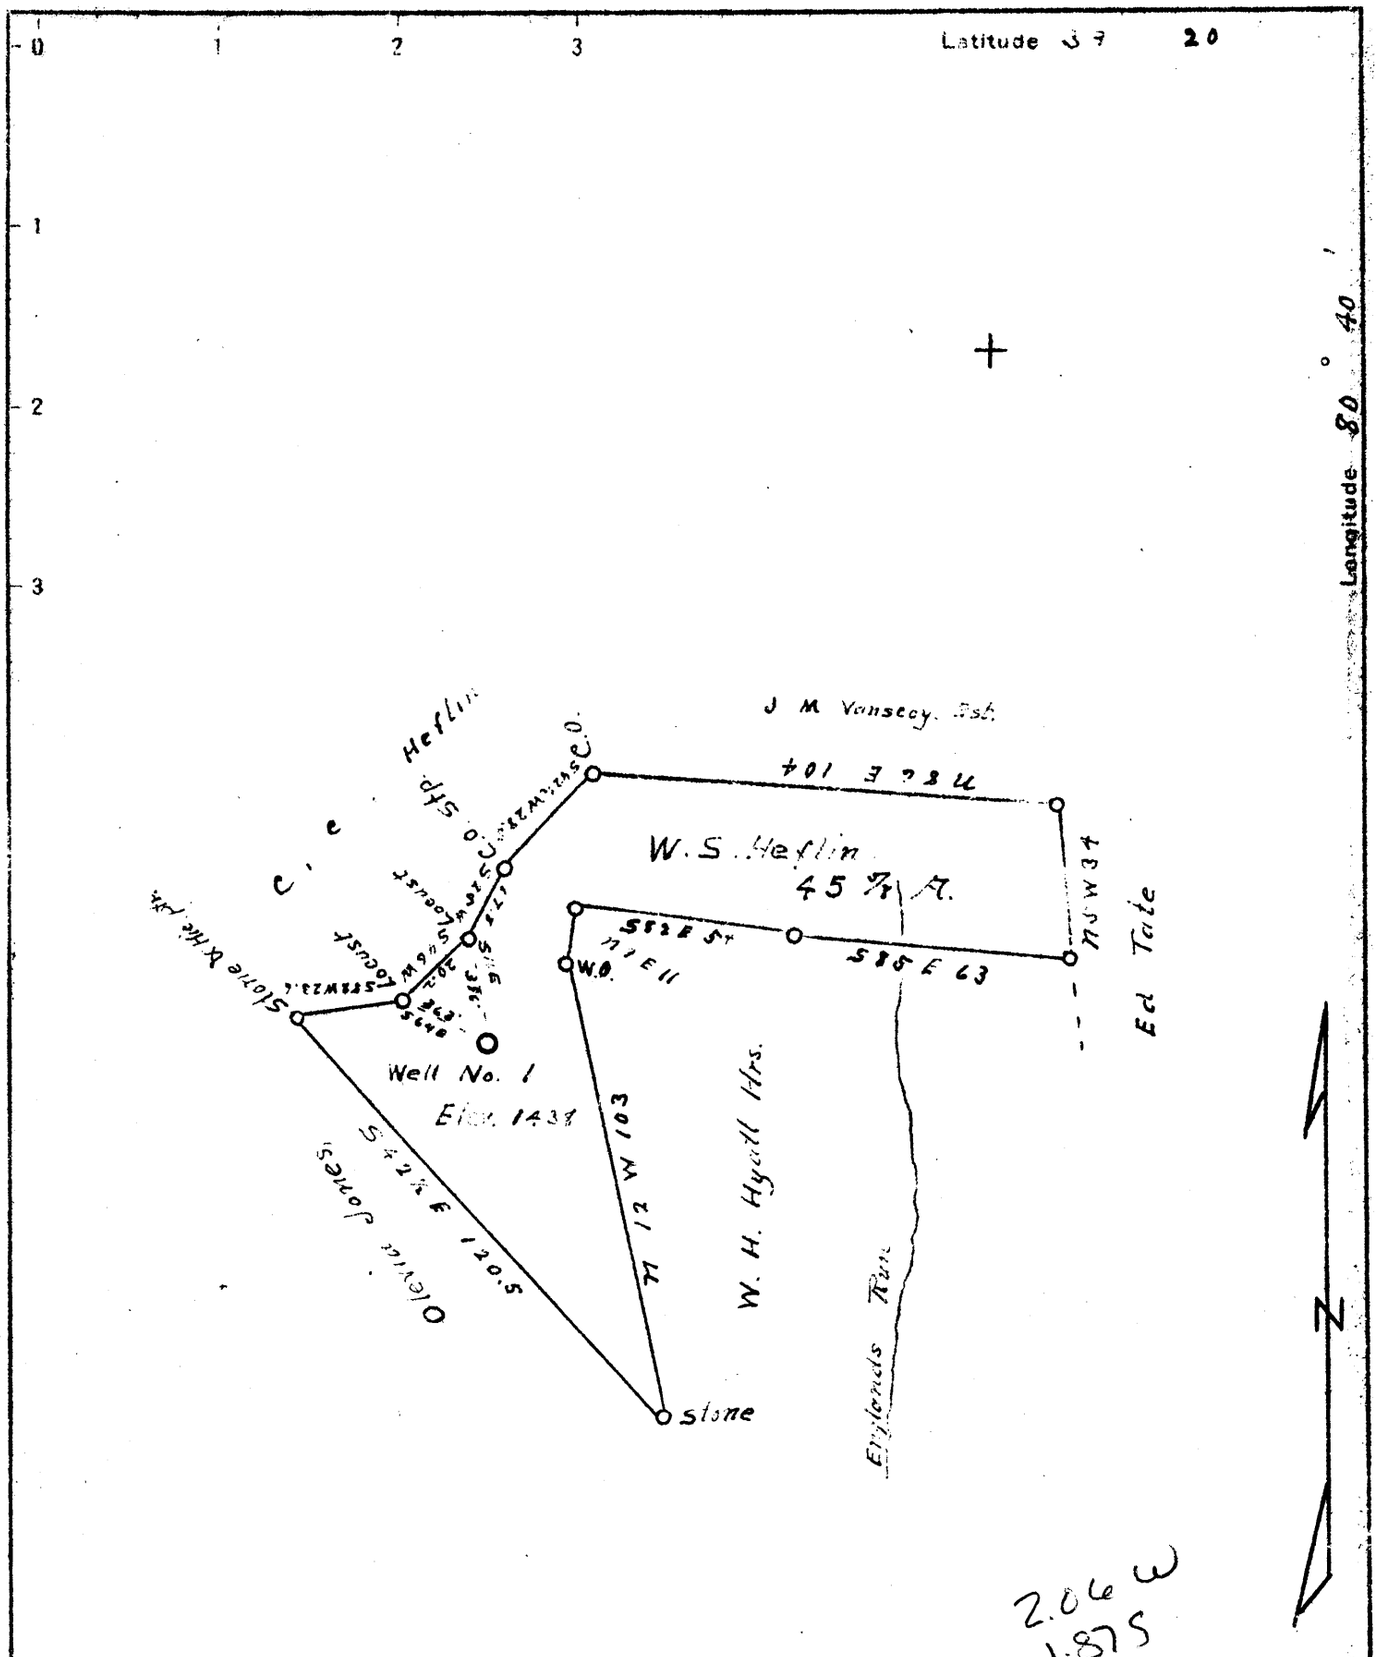

New Location X
Drill Deeper
Abandonment

Company Ed Tate & W.D. Gribble,
Address West Union, W.Va.
Farm W.S. Heflin.
Tract One Acres 45 7/8 Lease No.
Well (Farm) No. 1 Serial No.
Elevation (Spirit Level) 1438
Quadrangle Centerpoint SW
County Doddridge District West Union
Engineer J.M. Martin
Engineer's Registration No. 84
File No. Drawing No.
Date July 5" 1943 Scale 40 Poles = 1"

STATE OF WEST VIRGINIA
DEPARTMENT OF MINES
OIL AND GAS DIVISION
CHARLESTON

WELL LOCATION MAP

FILE NO. DOD-139

+ Denotes location of well on United States Topographic Maps, scale 1 to 62.500, latitude and longitude lines be[illegible] resented by border lines as show[illegible]

— Denotes one inch of original tracing

72619 on CN6