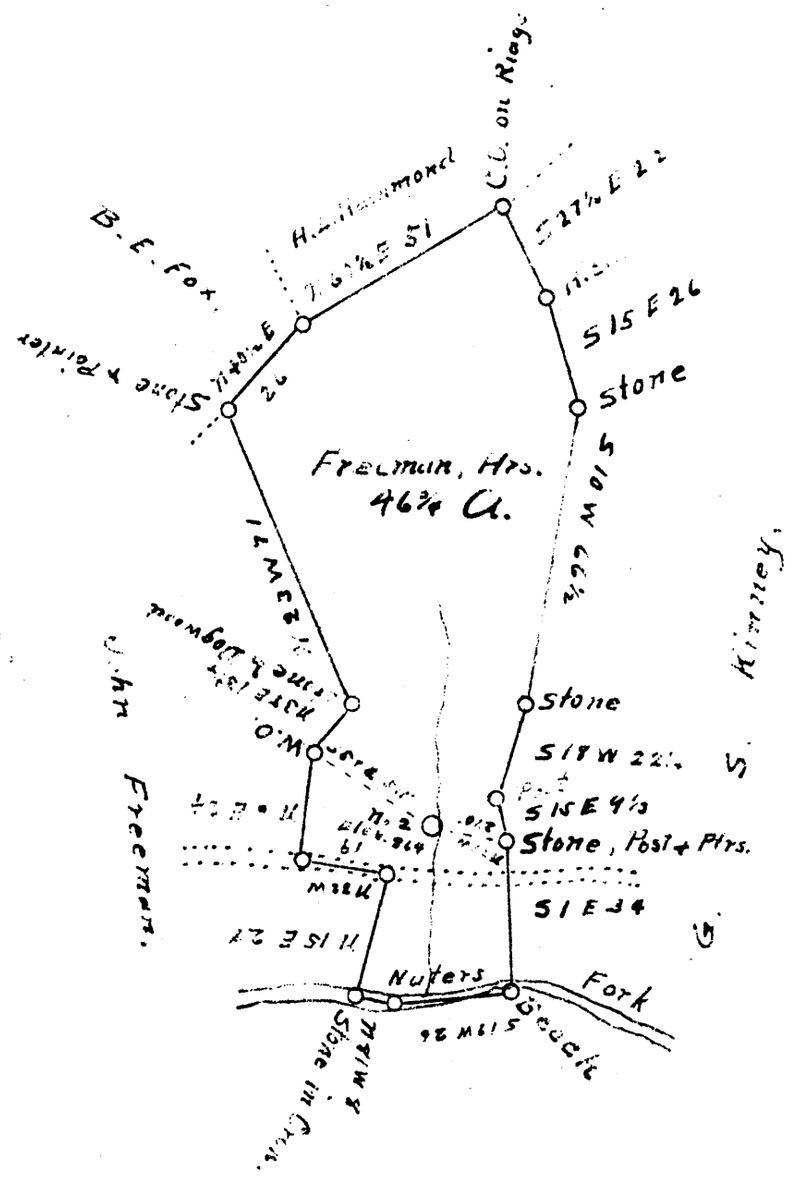

Longitude 80° 46'

5.625
0.230

New Location X
Drill Deeper
Abandonment

Company Braden & Creighton
Address Marietta, Ohio.
Farm Freeman Hrs.
Tract One Acres 46¾ Lease No.
Well (Farm) No. 2 Serial No.
Elevation (Spirit Level) 864
Quadrangle West Union EC
County Doddridge District West Union,
Engineer J. M. Martin
Engineer's Registration No. 84
File No. Drawing No.
Date Aug. 11 Scale 40 P = 1"

STATE OF WEST VIRGINIA
DEPARTMENT OF MINES
OIL AND GAS DIVISION
CHARLESTON

WELL LOCATION MAP

FILE NO. DOD-141

+ Denotes location of well on United States Topographic Maps, scale 1 to 62,500, latitude and longitude lines being represented by border lines as shown.

— Denotes one inch spaces on border line of original tracing.

"IMPERIAL" TRACING CLOTH
K & E CO., N.Y.