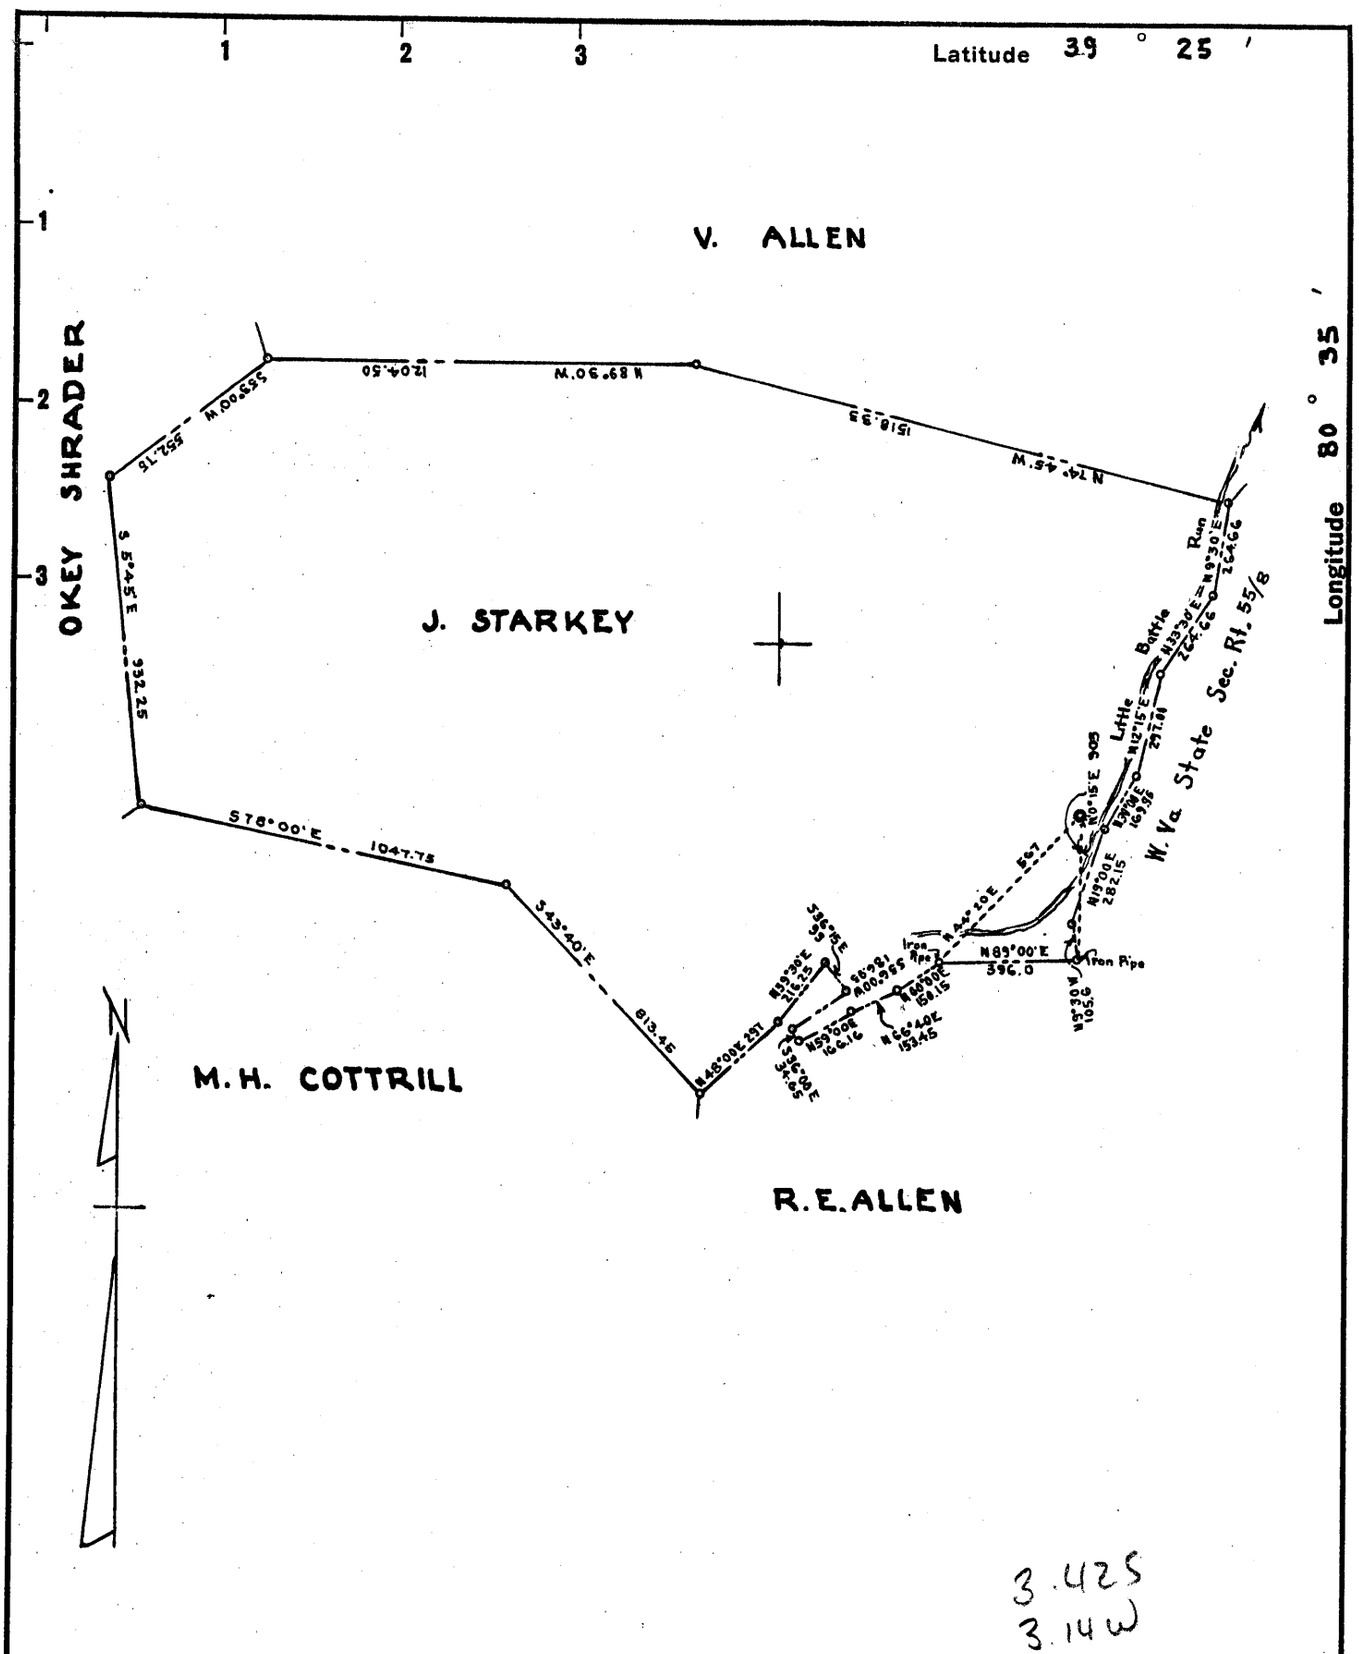

New Location ..☒
Drill Deeper .....☐
Abandonment.....☐

Company R. D. McCULLAUGH
Address EIGHTY-FOUR, PA.
Farm J. STARKEY
Tract _____ Acres 99.5 Lease No. _____
Well (Farm) No. 1 Serial No. _____
Elevation (Spirit Level) 913.1
Quadrangle CENTERPOINT
County DODDRIDGE District McCLELLAN
Engineer JOHN C. THRASHER
Engineer's Registration No. 3229
File No. _____ Drawing No. _____
Date SEPT. 10, 1957 Scale 1" = 500

STATE OF WEST VIRGINIA
DEPARTMENT OF MINES
OIL AND GAS DIVISION
CHARLESTON

WELL LOCATION MAP

FILE NO. DOD-231

+ Denotes location of well on United States Topographic Maps, scale 1 to 62,500, latitude and longitude lines being represented by border lines as shown.

— Denotes one inch spaces on border line of original tracing.

K&E 186 IMPERIAL 60046