

WW-7
8-30-06



West Virginia Department of Environmental Protection
Office of Oil and Gas
WELL LOCATION FORM: GPS

API: 4701700244 WELL NO.: BLUESTONE 4?
FARM NAME: Leeman Maxwell
RESPONSIBLE PARTY NAME: Stalnaker Energy Corp.
COUNTY: Doddridge DISTRICT: South West
QUADRANGLE: Oxford
SURFACE OWNER: Justin L. Henderson
ROYALTY OWNER: Justin L. Henderson
UTM GPS NORTHING: 4341666.8
UTM GPS EASTING: 520181.6 GPS ELEVATION: 920

The Responsible Party named above has chosen to submit GPS coordinates in lieu of preparing a new well location plat for a plugging permit or assigned API number on the above well. The Office of Oil and Gas will not accept GPS coordinates that do not meet the following requirements:

1. Datum: NAD 1983, Zone: 17 North, Coordinate Units: meters, Altitude: height above mean sea level (MSL) – meters.
2. Accuracy to Datum – 3.05 meters
3. Data Collection Method:
Survey grade GPS : Post Processed Differential

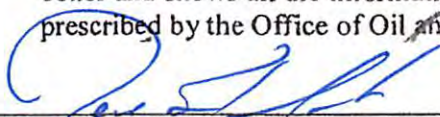
Real-Time Differential

Mapping Grade GPS : Post Processed Differential

Real-Time Differential

4. Letter size copy of the topography map showing the well location.

I the undersigned, hereby certify this data is correct to the best of my knowledge and belief and shows all the information required by law and the regulations issued and prescribed by the Office of Oil and Gas.


Signature

President
Title

12-13-16
Date

RECEIVED
Office of Oil and Gas

DEC 15 2016

WV Department of
Environmental Protection

1700244P



Google earth



12/16/2016