

WW-7
8-30-06



West Virginia Department of Environmental Protection
Office of Oil and Gas

WELL LOCATION FORM: GPS

API: 47-017-00438 WELL NO.: 2

FARM NAME: Christopher Davis

RESPONSIBLE PARTY NAME: Antero Resources Corporation

COUNTY: Doddridge DISTRICT: West Union

QUADRANGLE: West Union

SURFACE OWNER: Charles C Hittel III

ROYALTY OWNER: S&R Gas Ventures, Ltd.

UTM GPS NORTHING: 4356258.98 m

UTM GPS EASTING: 518054.92 m GPS ELEVATION: 898'

The Responsible Party named above has chosen to submit GPS coordinates in lieu of preparing a new well location plat for a plugging permit or assigned API number on the above well. The Office of Oil and Gas will not accept GPS coordinates that do not meet the following requirements:

- Datum: NAD 1983, Zone: 17 North, Coordinate Units: meters, Altitude: height above mean sea level (MSL) – meters.
- Accuracy to Datum – 3.05 meters
- Data Collection Method:

Survey grade GPS : Post Processed Differential _____
Real-Time Differential

Mapping Grade GPS : Post Processed Differential _____
Real-Time Differential

- Letter size copy of the topography map showing the well location.**

I the undersigned, hereby certify this data is correct to the best of my knowledge and belief and shows all the information required by law and the regulations issued and prescribed by the Office of Oil and Gas.

Mary Sita
Signature

Permitting Supervisor
Title


5/1/18
Date

RECEIVED
Office of Oil and Gas

MAY 04 2018

WV Department of
Environmental Protection

05/04/2018

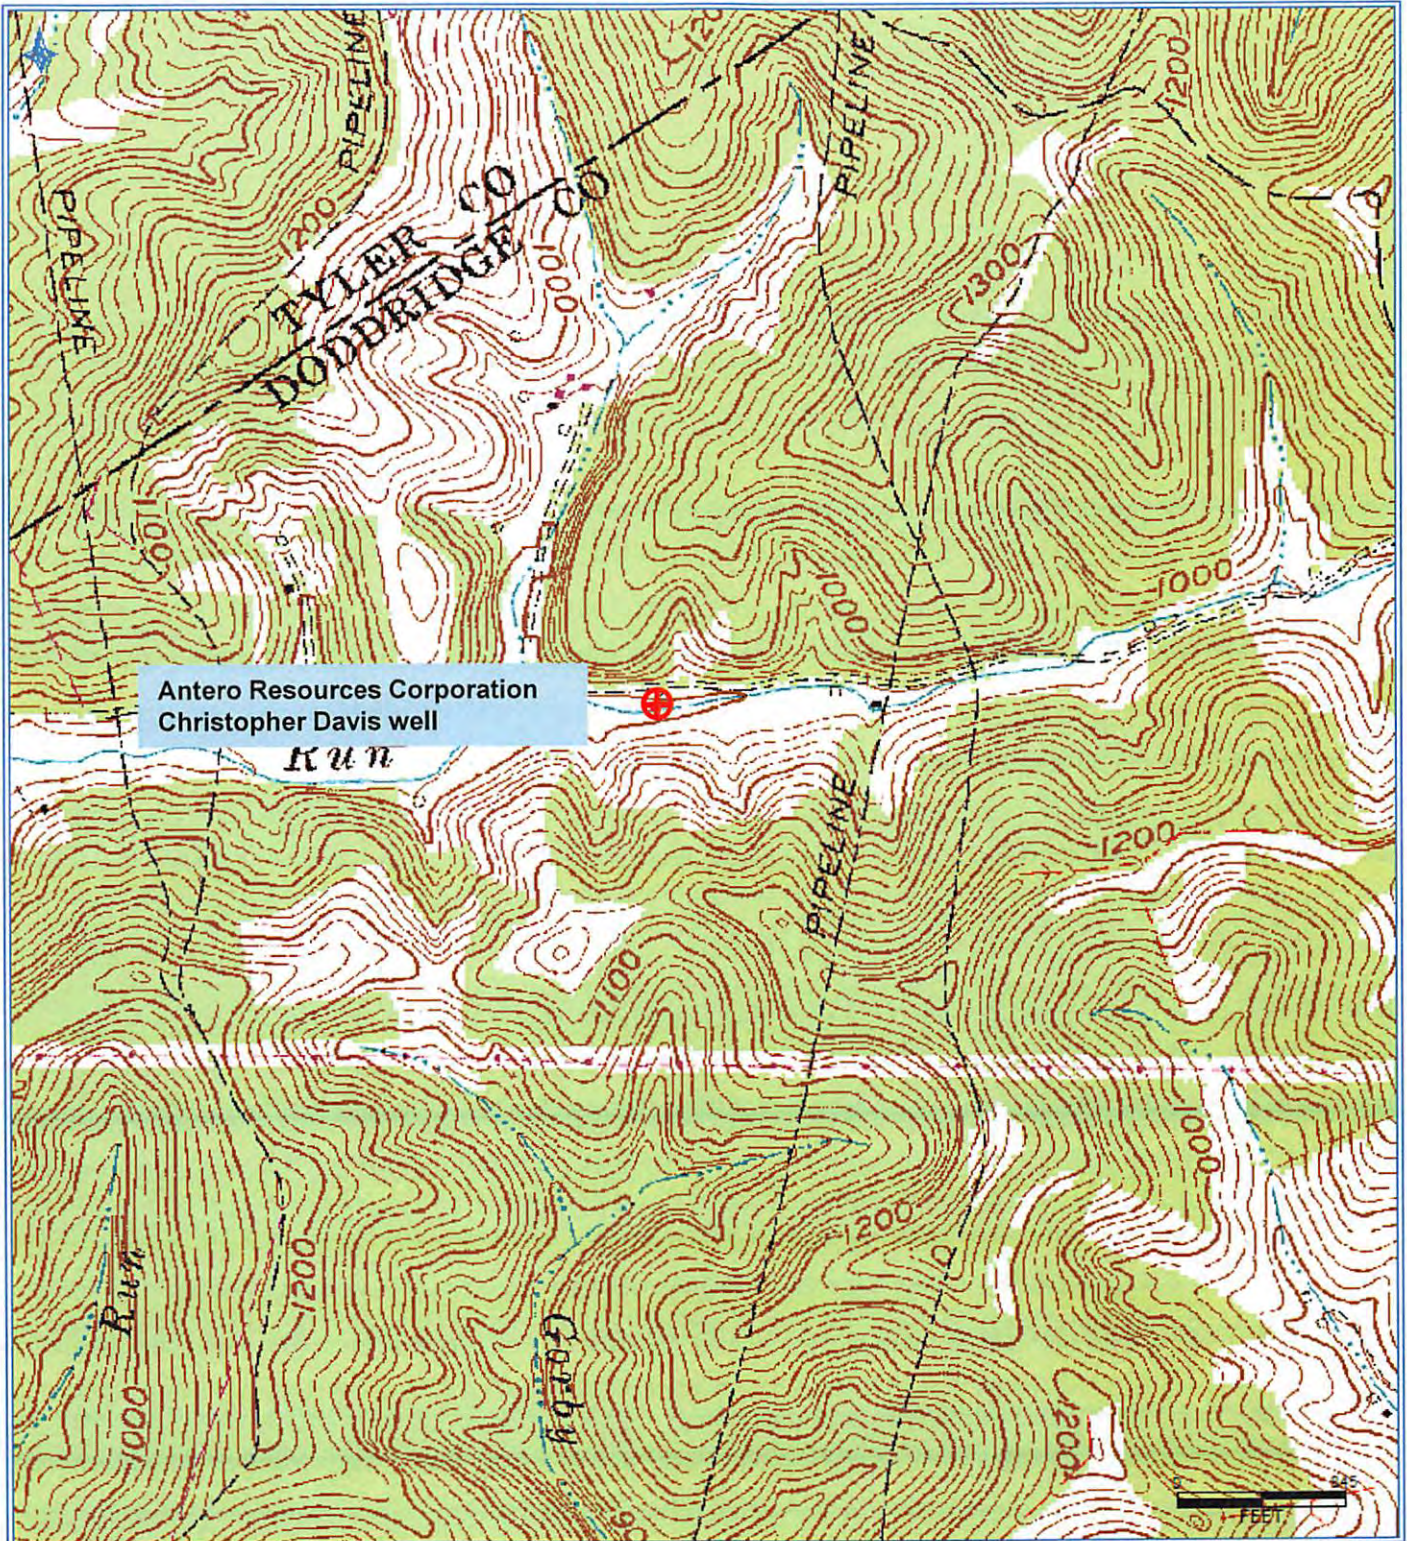

Antero Resources Corporation
 Christopher Davis well

Antero Resources Corporation
 Appalachian Basin
 Christopher Davis well
 Doddridge County

Quadrangle: West Union
 Watershed: Middle Island Creek
 District: West Union
 Date: 4-12-2018

RECEIVED
 Office of Oil and Gas

APR 13 2018

WV Department of
 Environmental Protection

05/04/2018