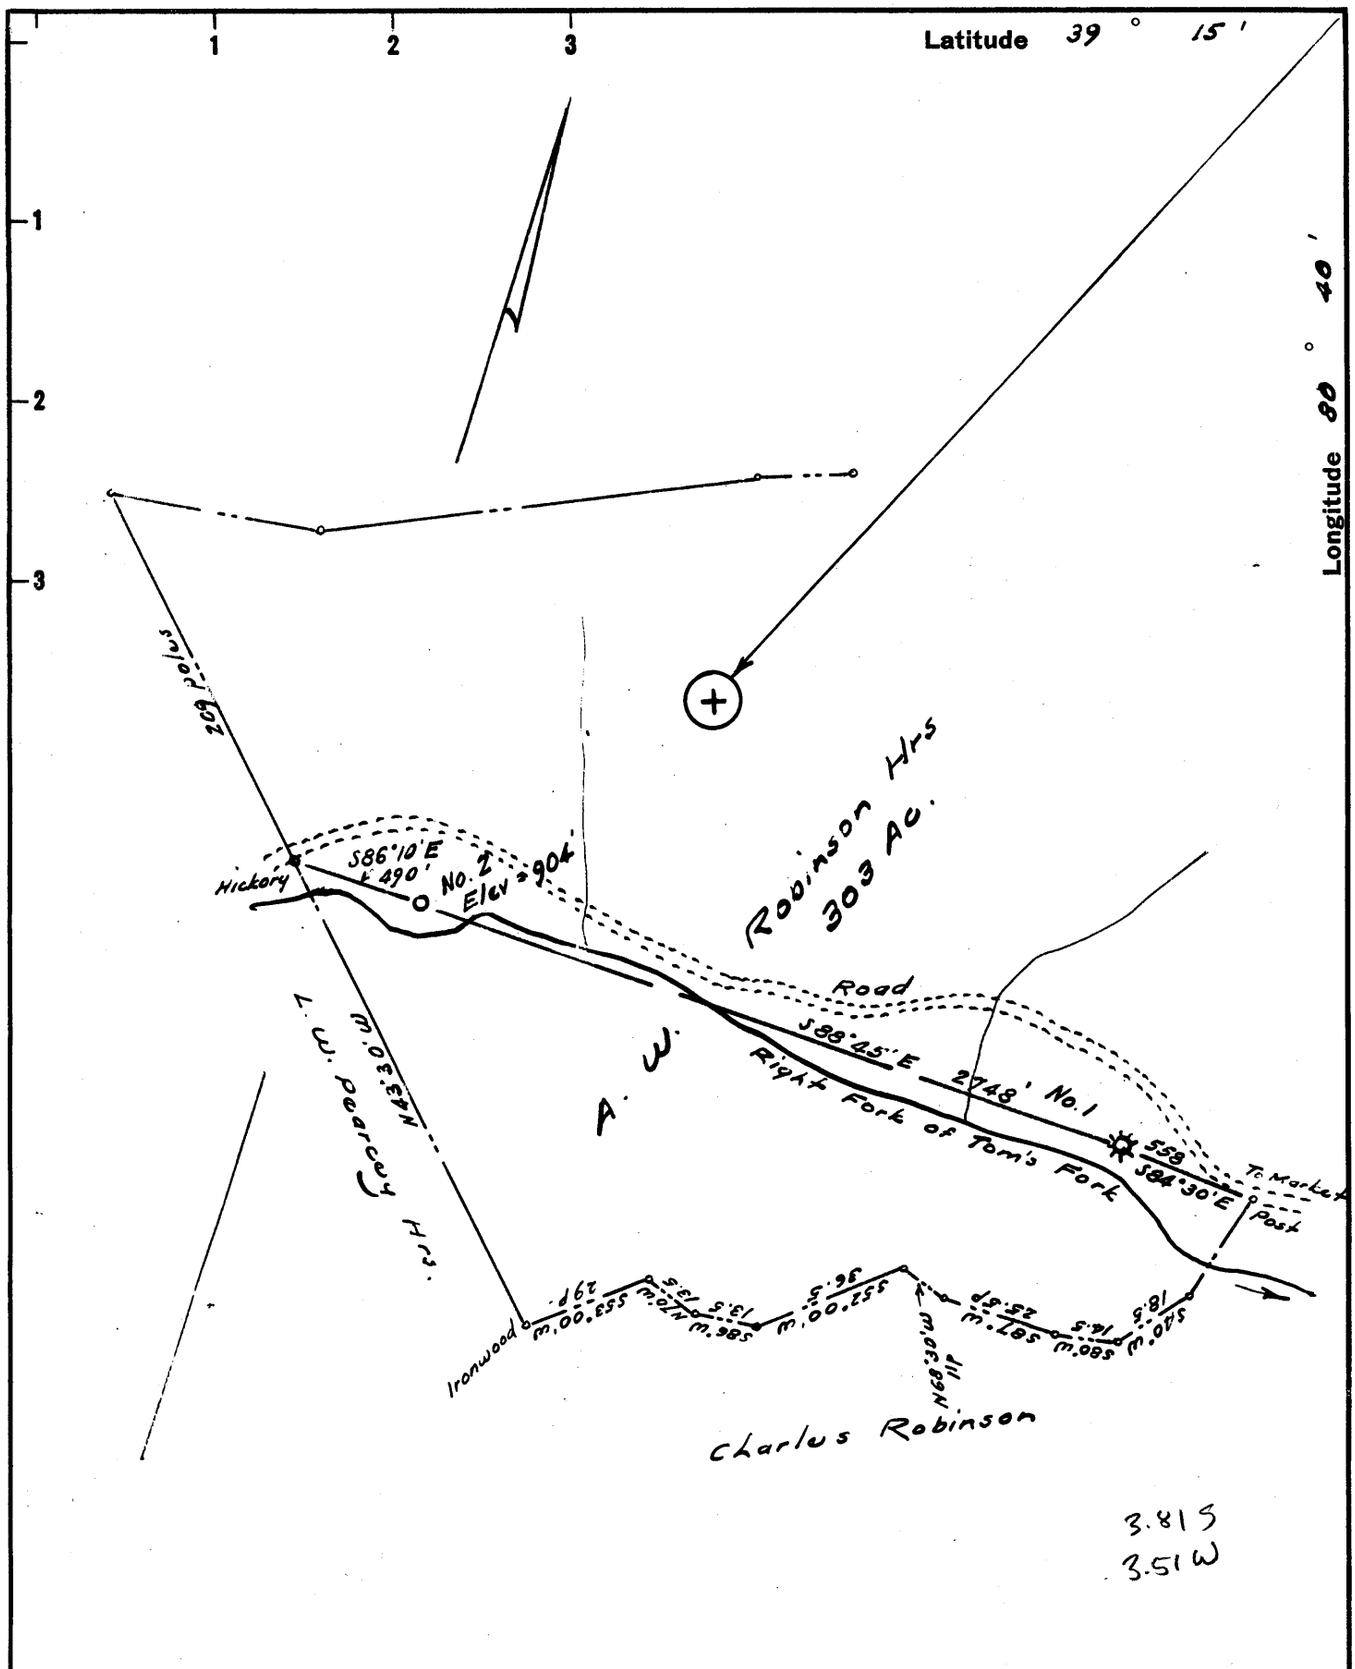

New Location ..■
Drill Deeper .....□
Abandonment.....□

No coal
Surface:- Paul Robinson, Salem, W.Va.

Company R. C. BATCHELOR
Address Box 116, West Union, W.Va.
Farm A. W. Robinson Heirs
Tract _____ Acres 303 Lease No. _____
Well (Farm) No. Two Serial No. _____
Elevation (Spirit Level) 904'
Quadrangle Vadis NW
County Doddridge District New Milton
Engineer [signature]
Engineer's Registration No. 1227
File No. _____ Drawing No. _____
Date August, 1960 Scale 1" = 40p.

STATE OF WEST VIRGINIA
DEPARTMENT OF MINES
OIL AND GAS DIVISION
CHARLESTON

WELL LOCATION MAP

FILE NO. DOD - 456

+ Denotes location of well on United States Topographic Maps, scale 1 to 62,500, latitude and longitude lines being represented by border lines as shown.

— Denotes one inch spaces on border line of original tracing.

156 IMPERIAL 66006