Plot ✓ Log 11 Card ✓ CSD___ Mflm___

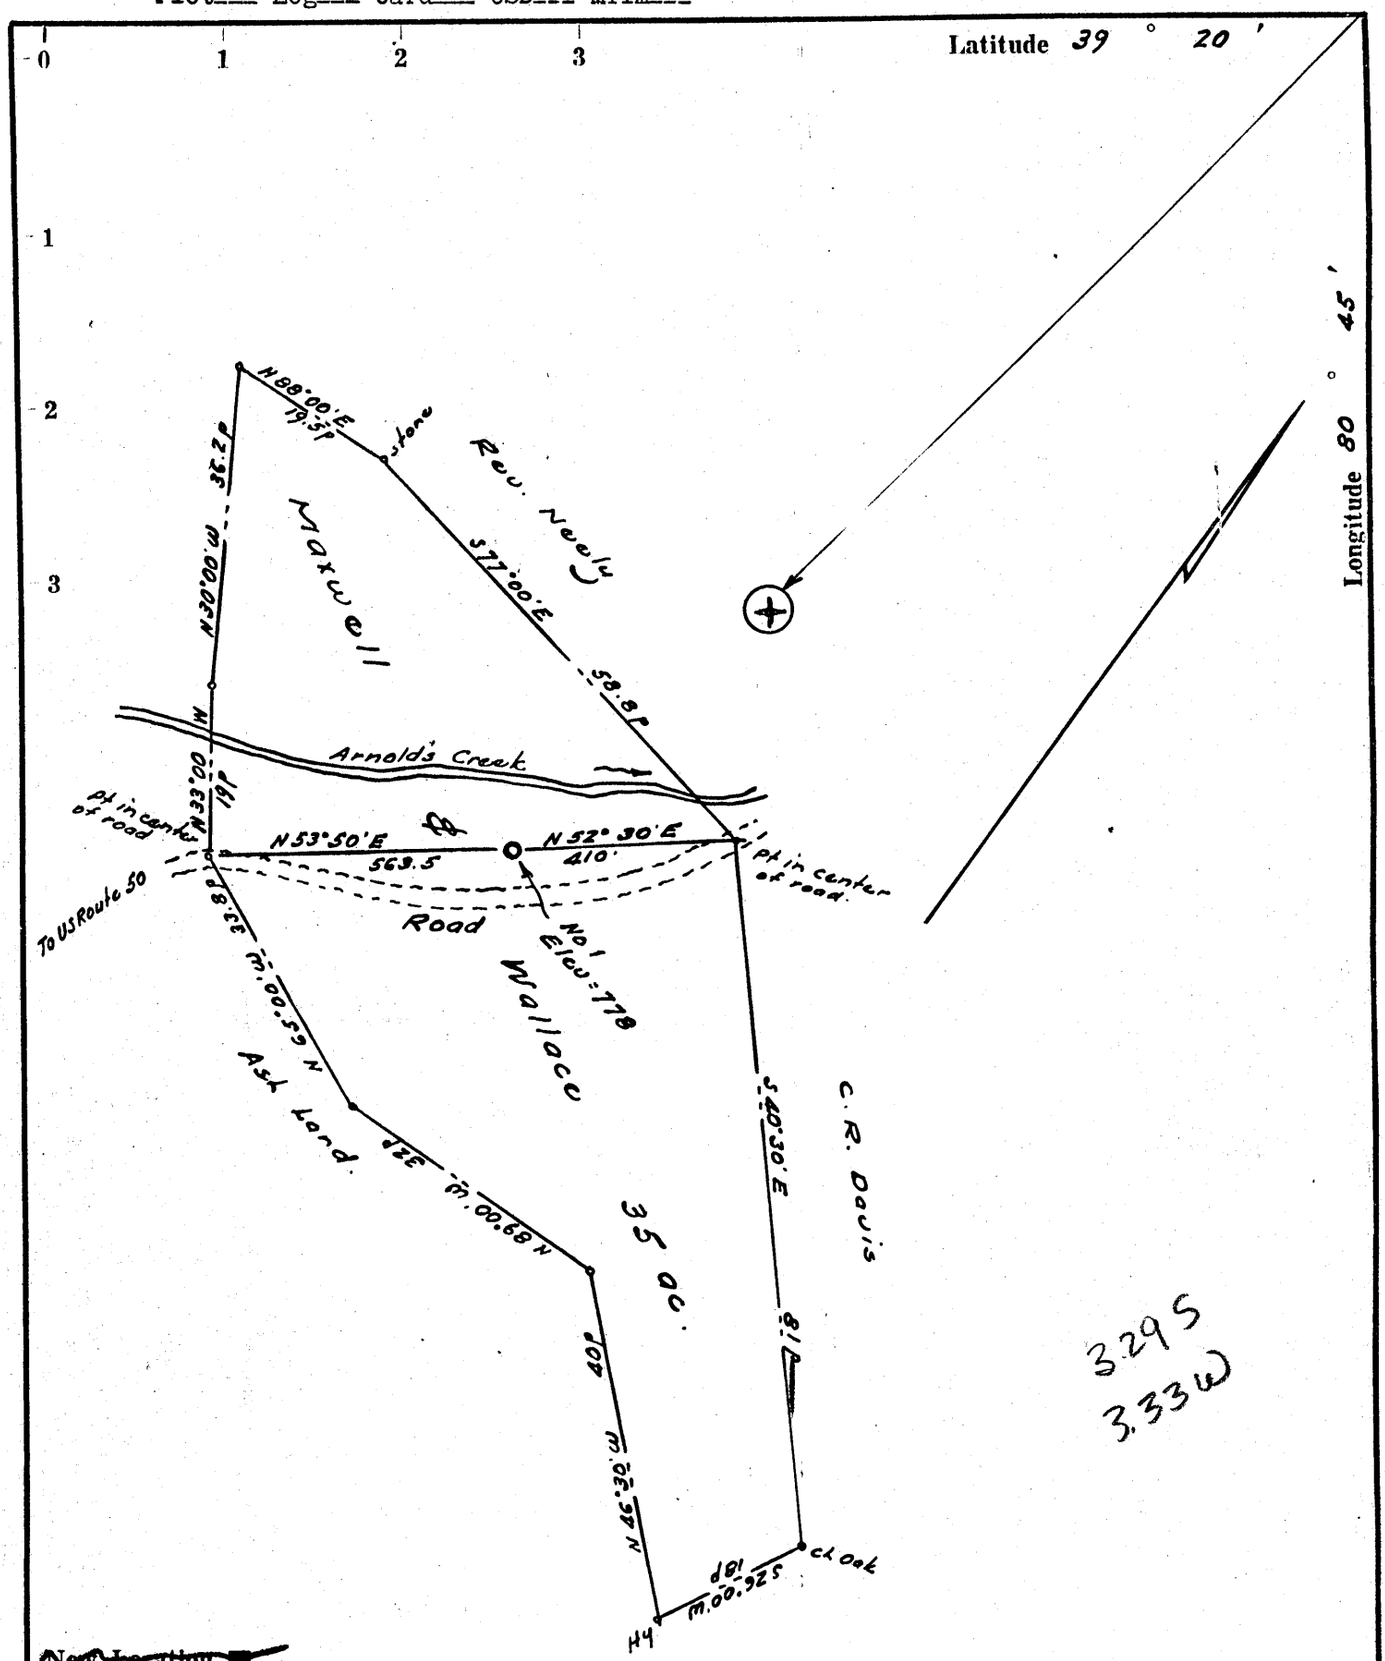

Company F. C. Stone, Oil & Gas
R. C. BAGHELOR Athens, Ohio
Address ~~Box 116, West Union, W. Va.~~
Farm Maxwell and Wallace
Tract ___ Acres 35 Lease No. ___
Well (Farm) No. One Serial No. ___
Elevation (Spirit Level) 778
Quadrangle West Union SE
County Doddridge District Central
Engineer ~~Hubbard~~
Engineer's Registration No. 1227
File No. ___ Drawing No. ___
Date Nov. 1960 Scale 1" = 20P.

STATE OF WEST VIRGINIA
DEPARTMENT OF MINES
OIL AND GAS DIVISION
CHARLESTON

WELL LOCATION MAP

FILE NO. DOD-499-P

+ Denotes location of well on United States Topographic Maps, scale 1 to 62,500, latitude and longitude lines being represented by border lines as shown.

— Denotes one inch spaces on border line of original tracing.

ALLEN BLUEPRINT & SUPPLY CO.

APR 08 1969