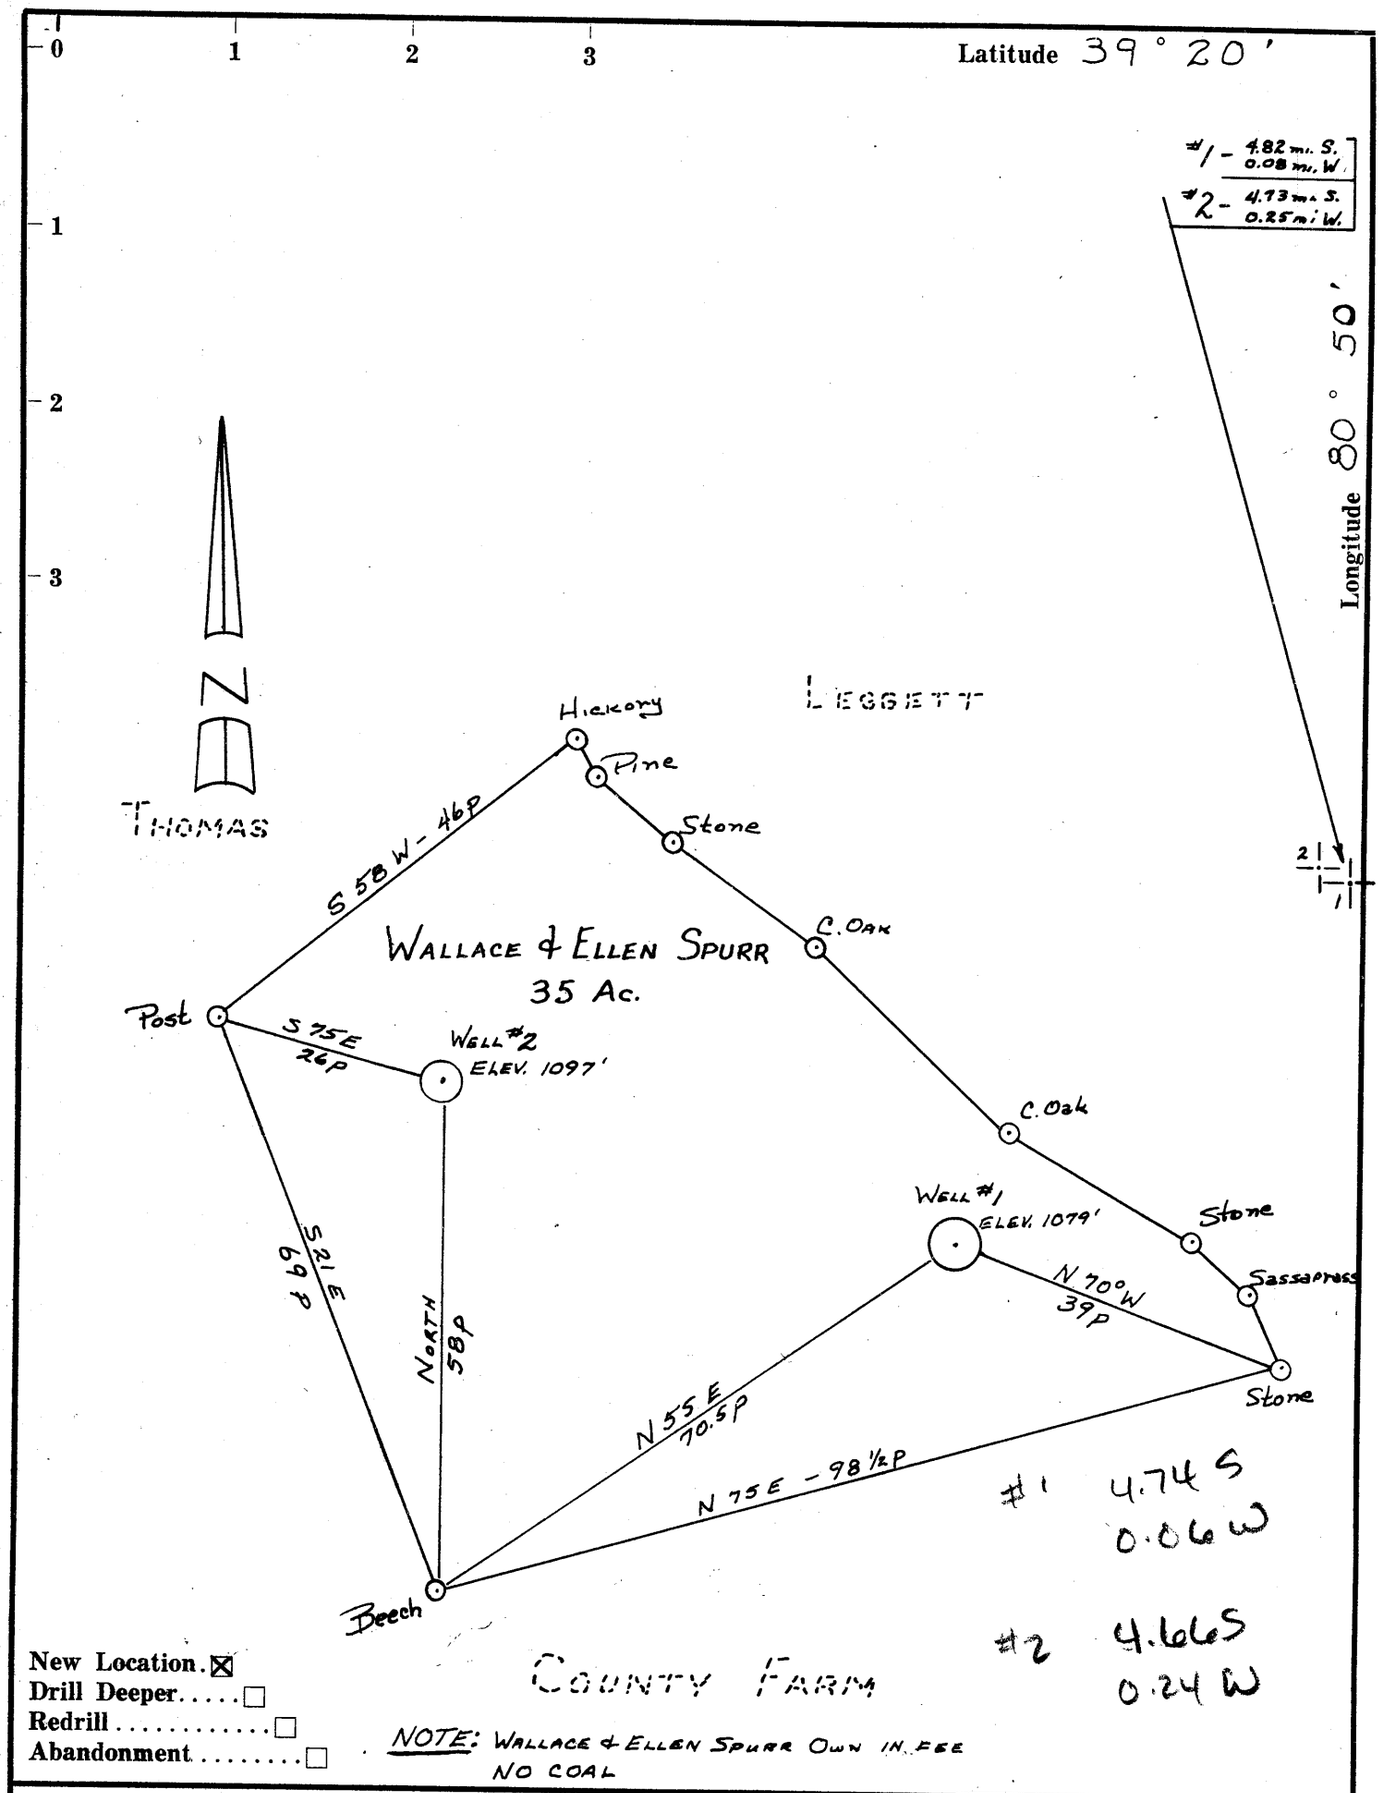


New Location. ☒
Drill Deeper..... ☐
Redrill..... ☐
Abandonment..... ☐

NOTE: WALLACE & ELLEN SPURR OWN IN FEE
NO COAL

Company R.C. Bachelor
Address Box 116, West Union, W.Va.
Farm Wallace Spurr
Tract _____ Acres 35 Lease No. _____
Well (Farm) No. 1 & 2 Serial No. _____
Elevation (Spirit Level) 1 - 1079' 2 - 1097'
Quadrangle West Union 5C
County Doddridge District Central
Engineer Chet Waterman
Engineer's Registration No. 3788
File No. _____ Drawing No. _____
Date 1/17/61 Scale 1" = 20p

STATE OF WEST VIRGINIA
DEPARTMENT OF MINES
OIL AND GAS DIVISION
CHARLESTON

# WELL LOCATION MAP

FILE NO. DOD - 519 #1
DOD - 520 #2

+ Denotes location of well on United States Topographic Maps, scale 1 to 62,500, latitude and longitude lines being represented by border lines as shown.

— Denotes one inch spaces on border line of original tracing.

ALLEN BLUEPRINT & SUPPLY CO.