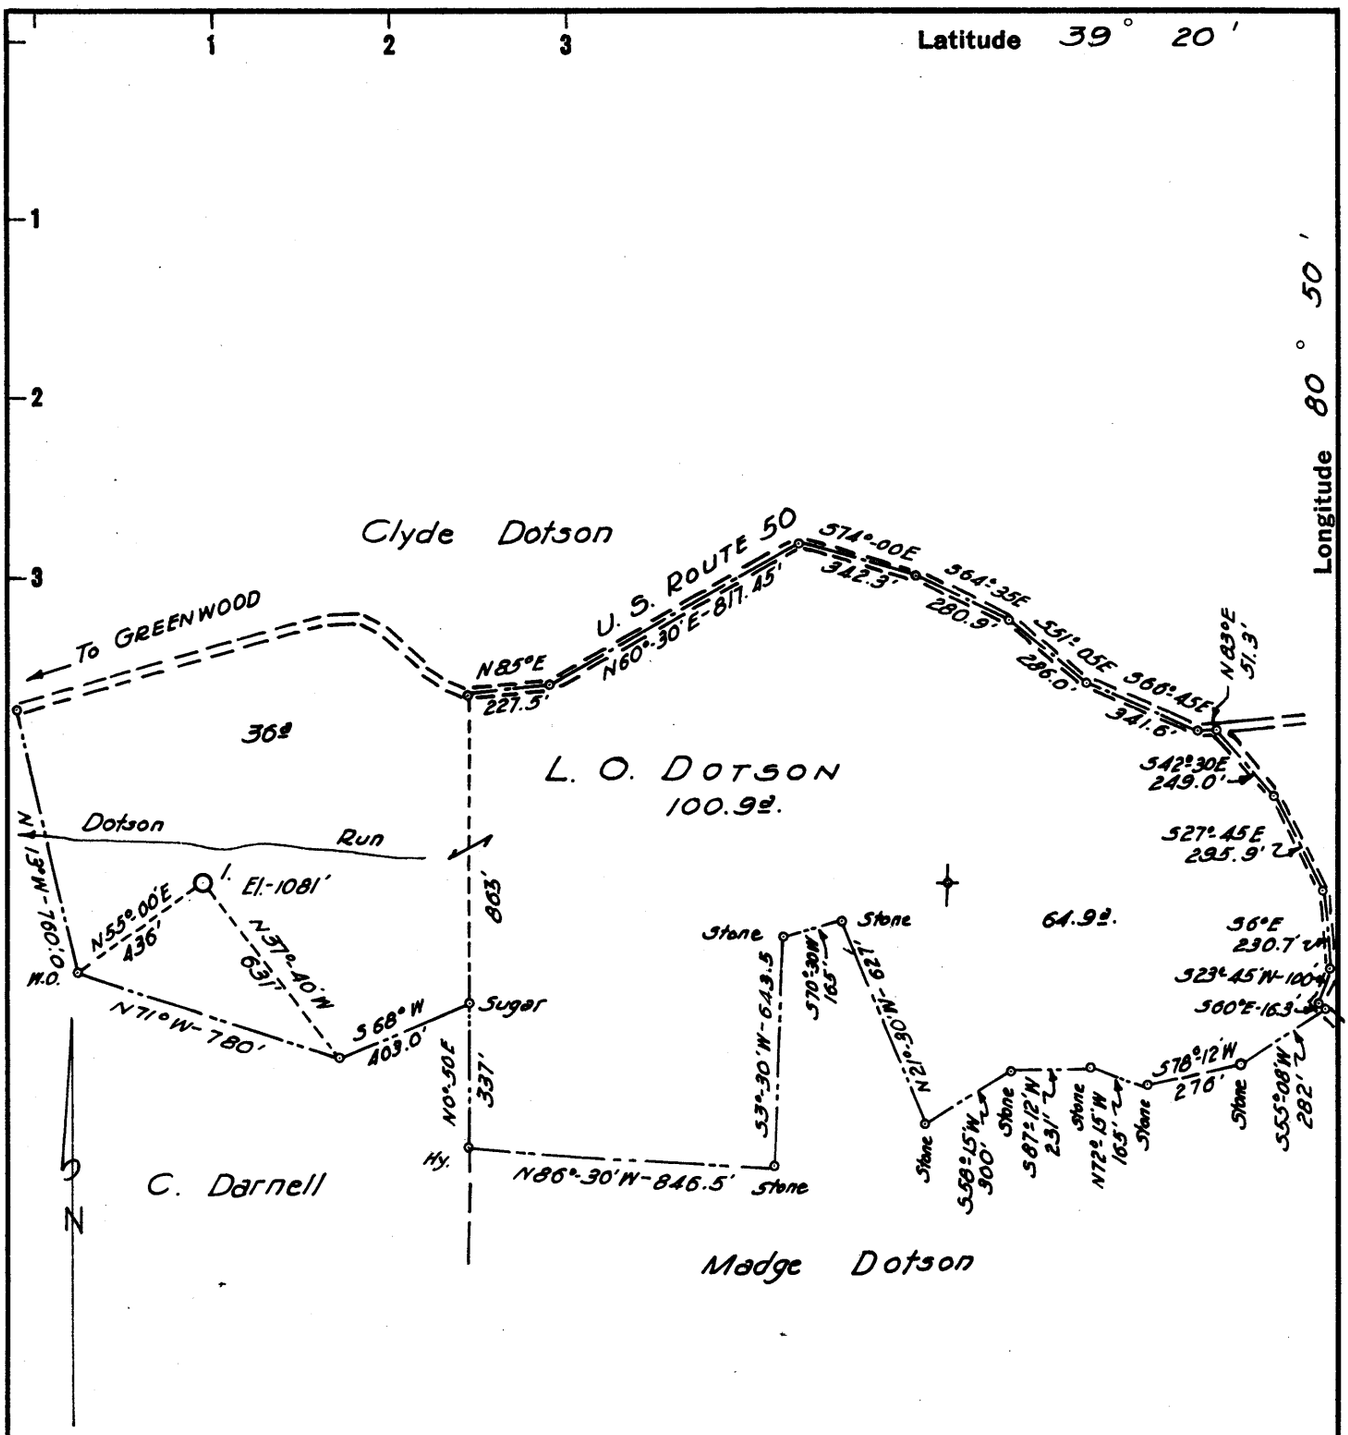

New Location ..☒
Drill Deeper .....☐
Abandonment.....☐

Company T. E. ALLEN & ASSOCIATES
Address BOX 176 WEST UNION, W. VA.
Farm L. O. DOTSON
Tract _____ Acres 100.9 Lease No. _____
Well (Farm) No. 1 Serial No. _____
Elevation (Spirit Level) 1081'
Quadrangle WEST UNION SC
County DODDRIDGE District CENTRAL
Engineer John W. Hamilton
Engineer's Registration No. 2274
File No. _____ Drawing No. _____
Date MAY 15, 1961 Scale 1" = 500'

STATE OF WEST VIRGINIA
DEPARTMENT OF MINES
OIL AND GAS DIVISION
CHARLESTON

WELL LOCATION MAP

FILE NO. DOD-558

carc O+G Div An Rept-1961

+ Denotes location of well on United States Topographic Maps, scale 1 to 62,500, latitude and longitude lines being represented by border lines as shown.

— Denotes one inch spaces on border line of original tracing.

K+E 156 IMPERIAL TRACING CLOTH T.M 65006