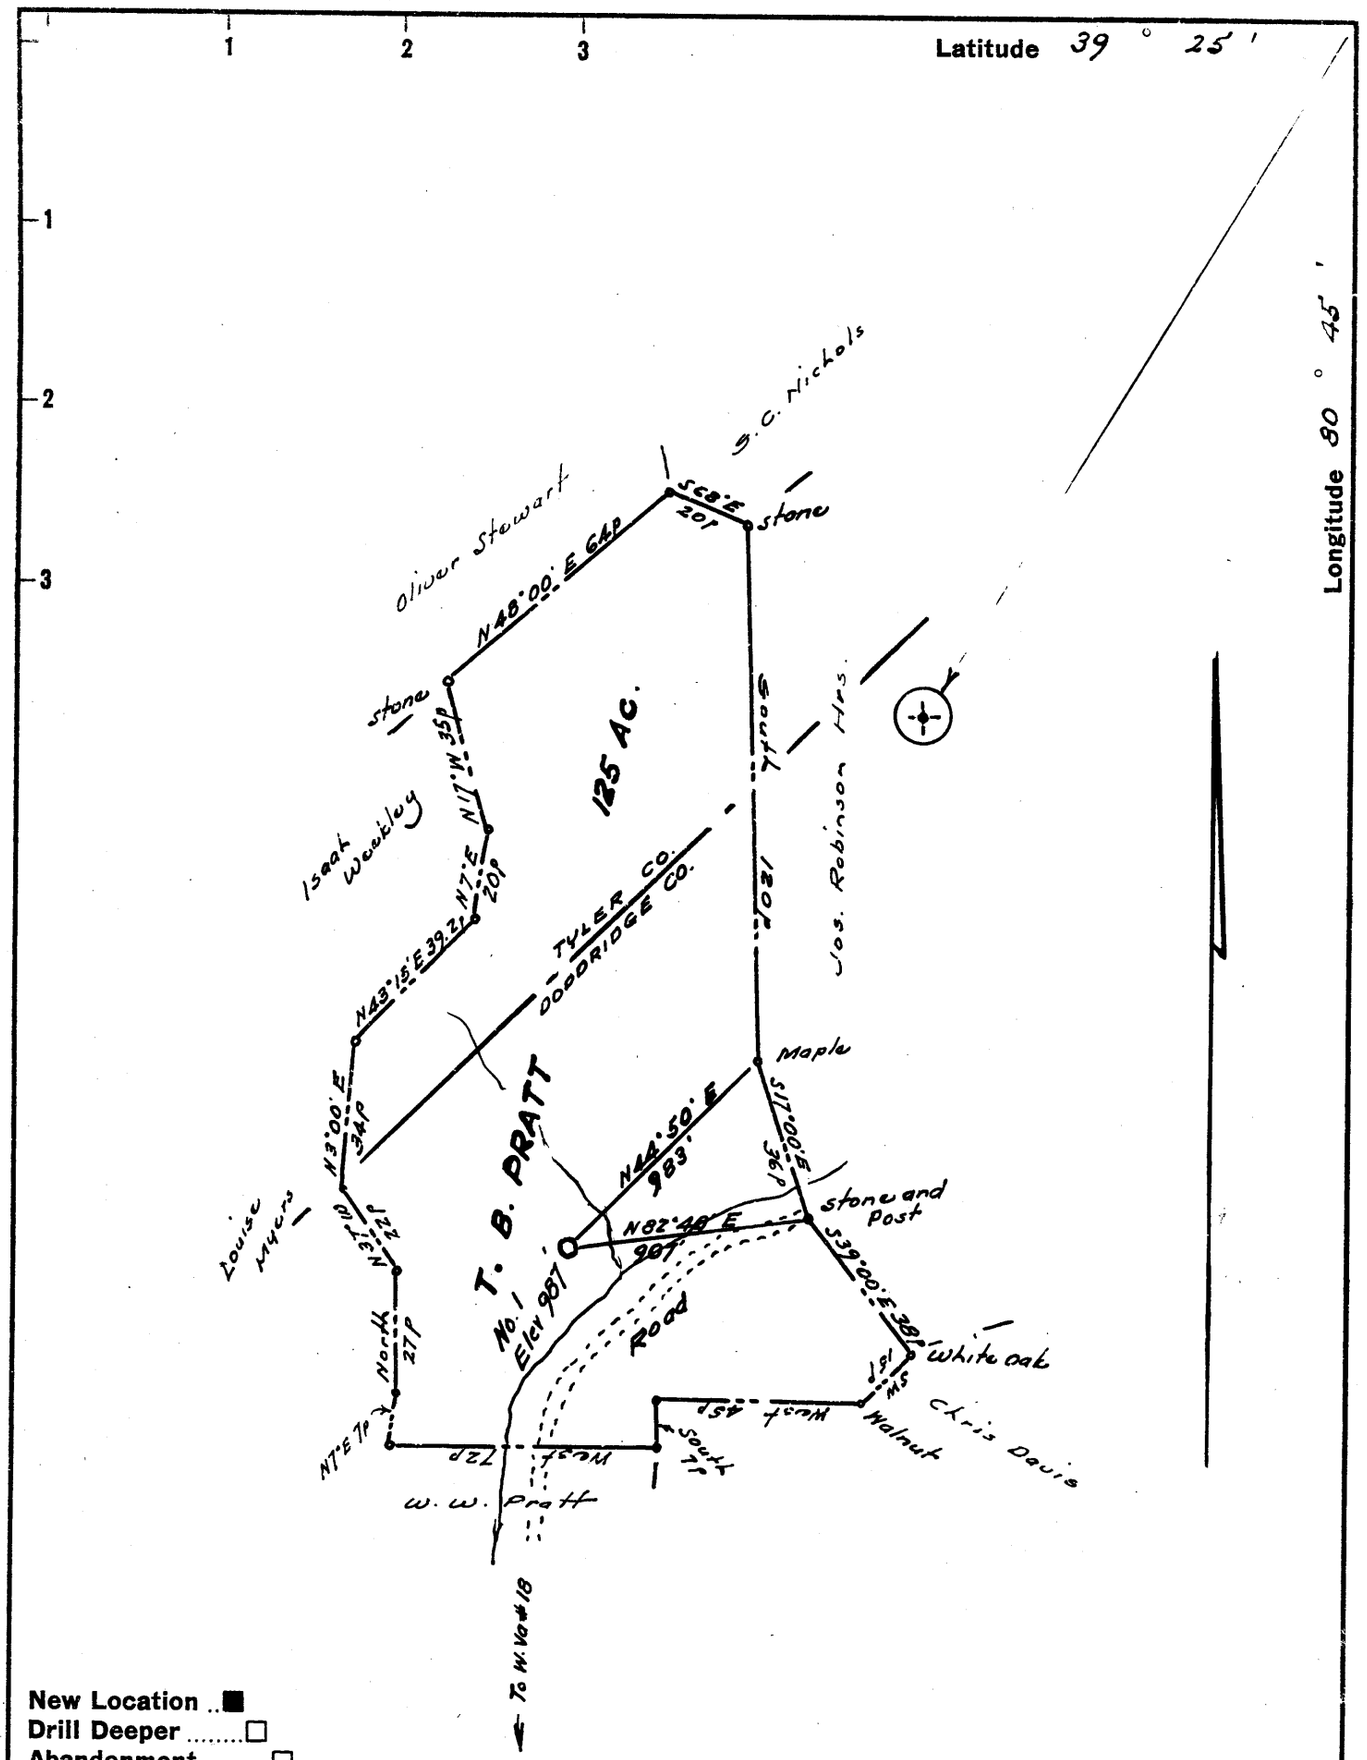

New Location ..■
Drill Deeper .....□
Abandonment.....□

Company OLE COLONY DEVELOPMENT CO.
Address Box 158, West Union, W.Va.
Farm T. B. Pratt
Tract _____ Acres 125 Lease No. _____
Well (Farm) No. One Serial No. _____
Elevation (Spirit Level) 987
Quadrangle West Union - EC
County Doddridge District Grant
Engineer [signature]
Engineer's Registration No. 1227
File No. _____ Drawing No. _____
Date August 1961 Scale 1" = 40p

STATE OF WEST VIRGINIA
DEPARTMENT OF MINES
OIL AND GAS DIVISION
CHARLESTON

WELL LOCATION MAP

FILE NO. Dod-630

Conc-Oil & Div An Rpt 1961 Table 5

+ Denotes location of well on United States Topographic Maps, scale 1 to latitude and longitude lines being represented by border lines as shown.

— Denotes one inch spaces on border line of original tracing.

K+E 155 IMPERIAL TRACING CLOTH 68347