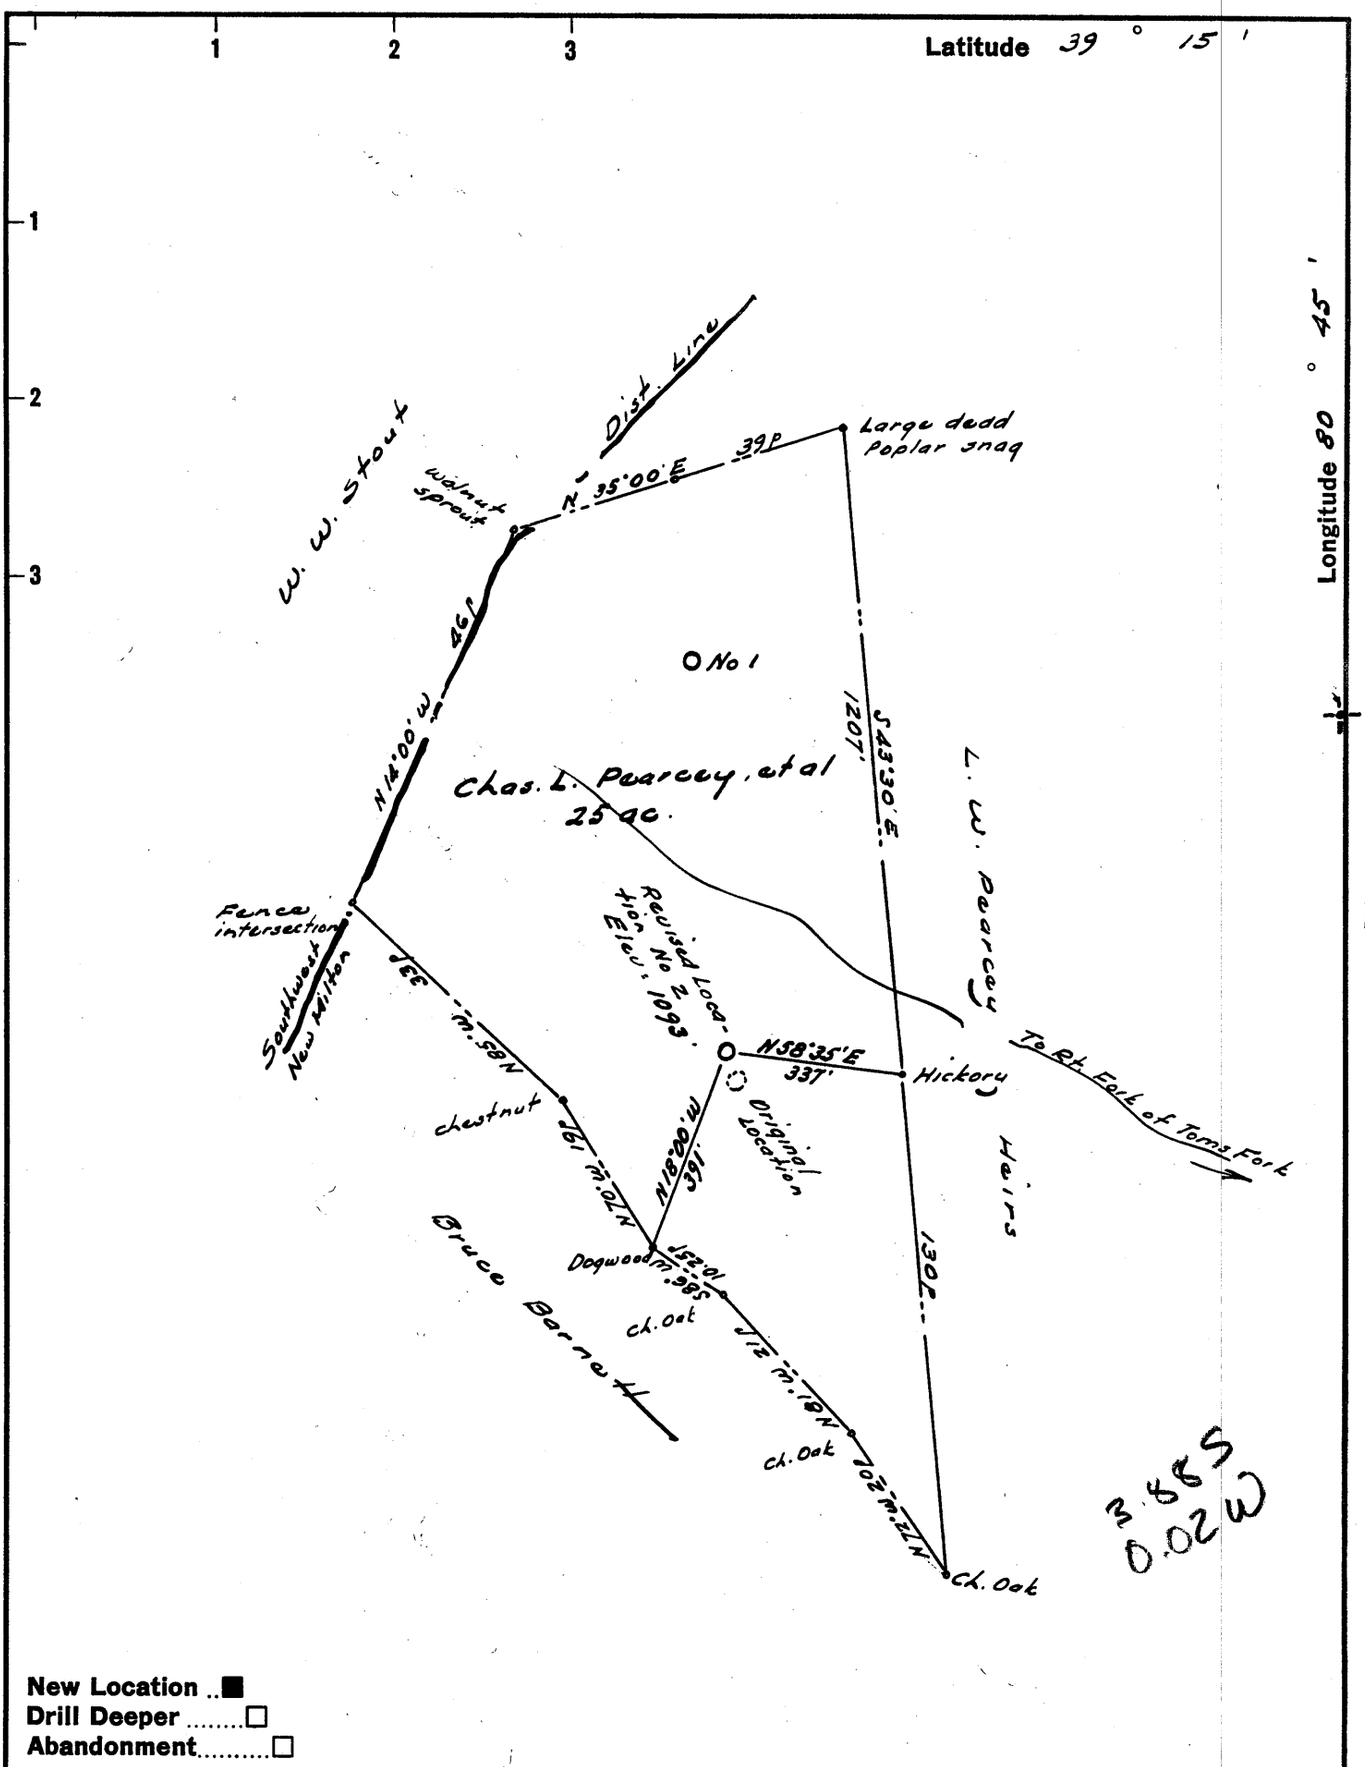

New Location ..■
Drill Deeper .....□
Abandonment.....□

Company *Trio Oil & Gas Co., Inc.*
Address *c/o Paul Davis, West Union, W.Va.*
Farm *Charles L. Pearcey, et al*
Tract _____ Acres *25 ac* Lease No. _____
Well (Farm) No. *Two* Serial No. _____
Elevation (Spirit Level) *1093*
Quadrangle *Holbrook NE*
County *Doddridge* District *New Milton*
Engineer *[illegible]*
Engineer's Registration No. *1227*
File No. _____ Drawing No. _____
Date *August 3, 1962* Scale *1" = 20p = 330'*

Sec 1

STATE OF WEST VIRGINIA
DEPARTMENT OF MINES
OIL AND GAS DIVISION
CHARLESTON

WELL LOCATION MAP

FILE NO. *DoD-837-(Revised)*
Well No. 2

+ Denotes location of well on United States Topographic Maps, scale 1 to 62,500, latitude and longitude lines being represented by border lines as shown.

— Denotes one inch spaces on border line of original tracing.

K+E 186 IMPERIAL TRACING CLOTH T.M. 69288