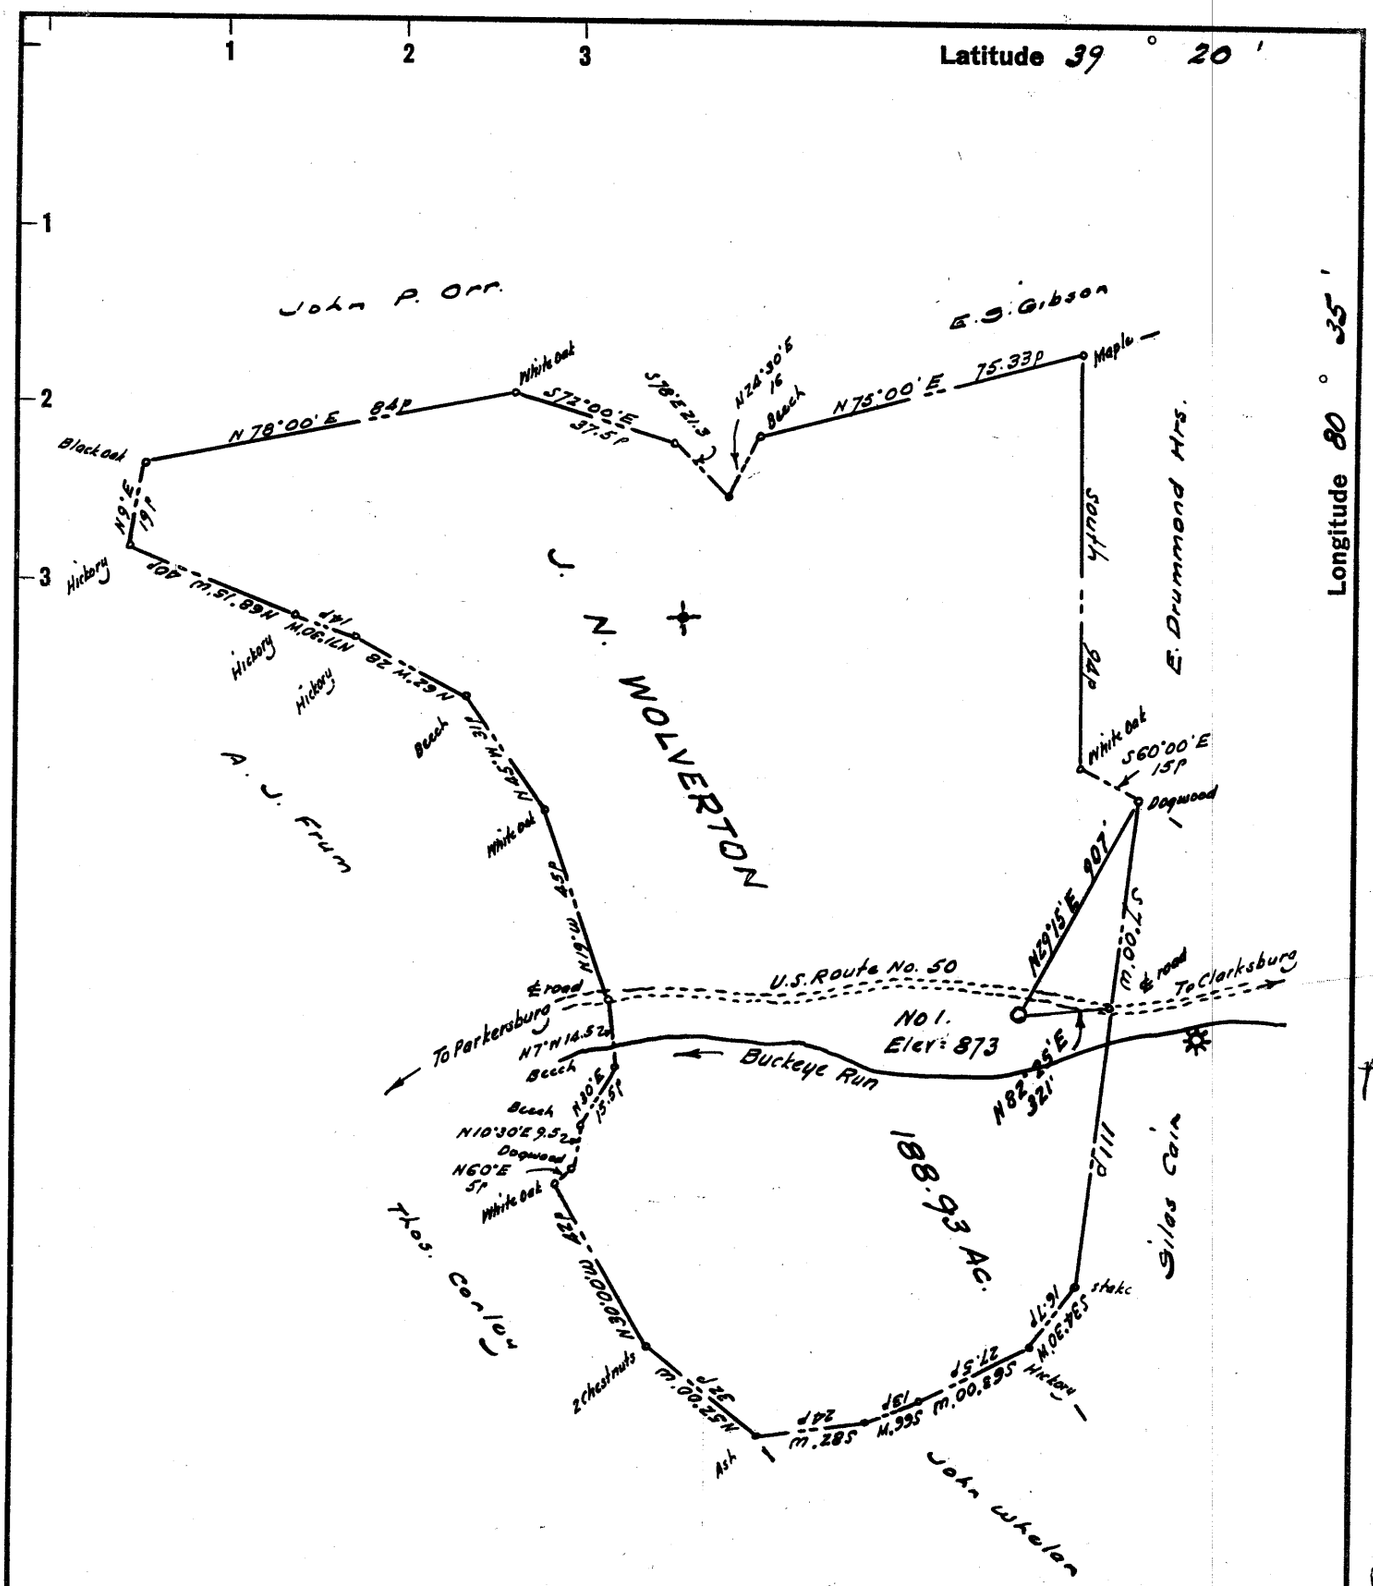

New Location ..■
Drill Deeper .....□
Abandonment.....□

Company NATIONAL PRODUCERS, INC.
Address Box 218, Pennsboro, West Va.
Farm J. N. Wolverton
Tract _____ Acres 188.93 Lease No. _____
Well (Farm) No. One Serial No. _____
Elevation (Spirit Level) 873
Quadrangle Centerpoint 5C
County Doddridge District Grant
Engineer [illegible]
Engineer's Registration No. 1227
File No. _____ Drawing No. _____
Date July 6, 1962 Scale 1" = 40p = 660'

STATE OF WEST VIRGINIA
DEPARTMENT OF MINES
OIL AND GAS DIVISION
CHARLESTON

WELL LOCATION MAP

FILE NO. Dod-838

Canc - O+G Div. An. Rpt 1962, Table 5

+ Denotes location of well on United States Topographic Maps, scale 1 to 62,500, latitude and longitude lines being represented by border lines as shown.

— Denotes one inch spaces on border line of original tracing.

K+E 156 IMPERIAL TRACING CLOTH T.M. 69288