 

MINIMUM ERROR OF CLOSURE 1/500

SOURCE OF ELEVATION Well No 1 this farm (W.B & Gertie Swiger) El. 1002

New Location X
Drill Deeper
Abandonment

"I, THE UNDERSIGNED HEREBY CERTIFY THAT THIS MAP IS CORRECT TO THE BEST OF MY KNOWLEDGE AND BELIEF AND SHOWS ALL THE INFORMATION REQUIRED BY PARAGRAPH 6 OF THE RULES AND REGULATIONS OF THE OIL AND GAS SECTION OF THE MINING LAWS OF WEST VIRGINIA."

Company Ritchie Oil Co., R. Daugherty, Agt.
Address Pennsboro, W. Va.
Farm W. B. & Gertie Swiger
Tract 1 Acres 100 Lease No.
Well (Farm) No. 2 Serial No.
Elevation (Spirit Level) 991
Quadrangle Centerpoint WC
County Doddridge District McClellan
Engineer Parker E. Peters
Engineer's Registration No. 485
File No. Drawing No.
Date June 11, 1963 Scale 1" = 30 P

STATE OF WEST VIRGINIA
DEPARTMENT OF MINES
OIL AND GAS DIVISION
CHARLESTON

WELL LOCATION MAP

FILE NO. DoD-1017

-|- Denotes location of well on United States Topographic Maps, scale 1 to 62,500, latitude and longitude lines being represented by border lines as shown.

— Denotes one inch spaces on border line of original tracing.

Stephens Blueprint and Supply Company · Parkersburg, W. Virginia

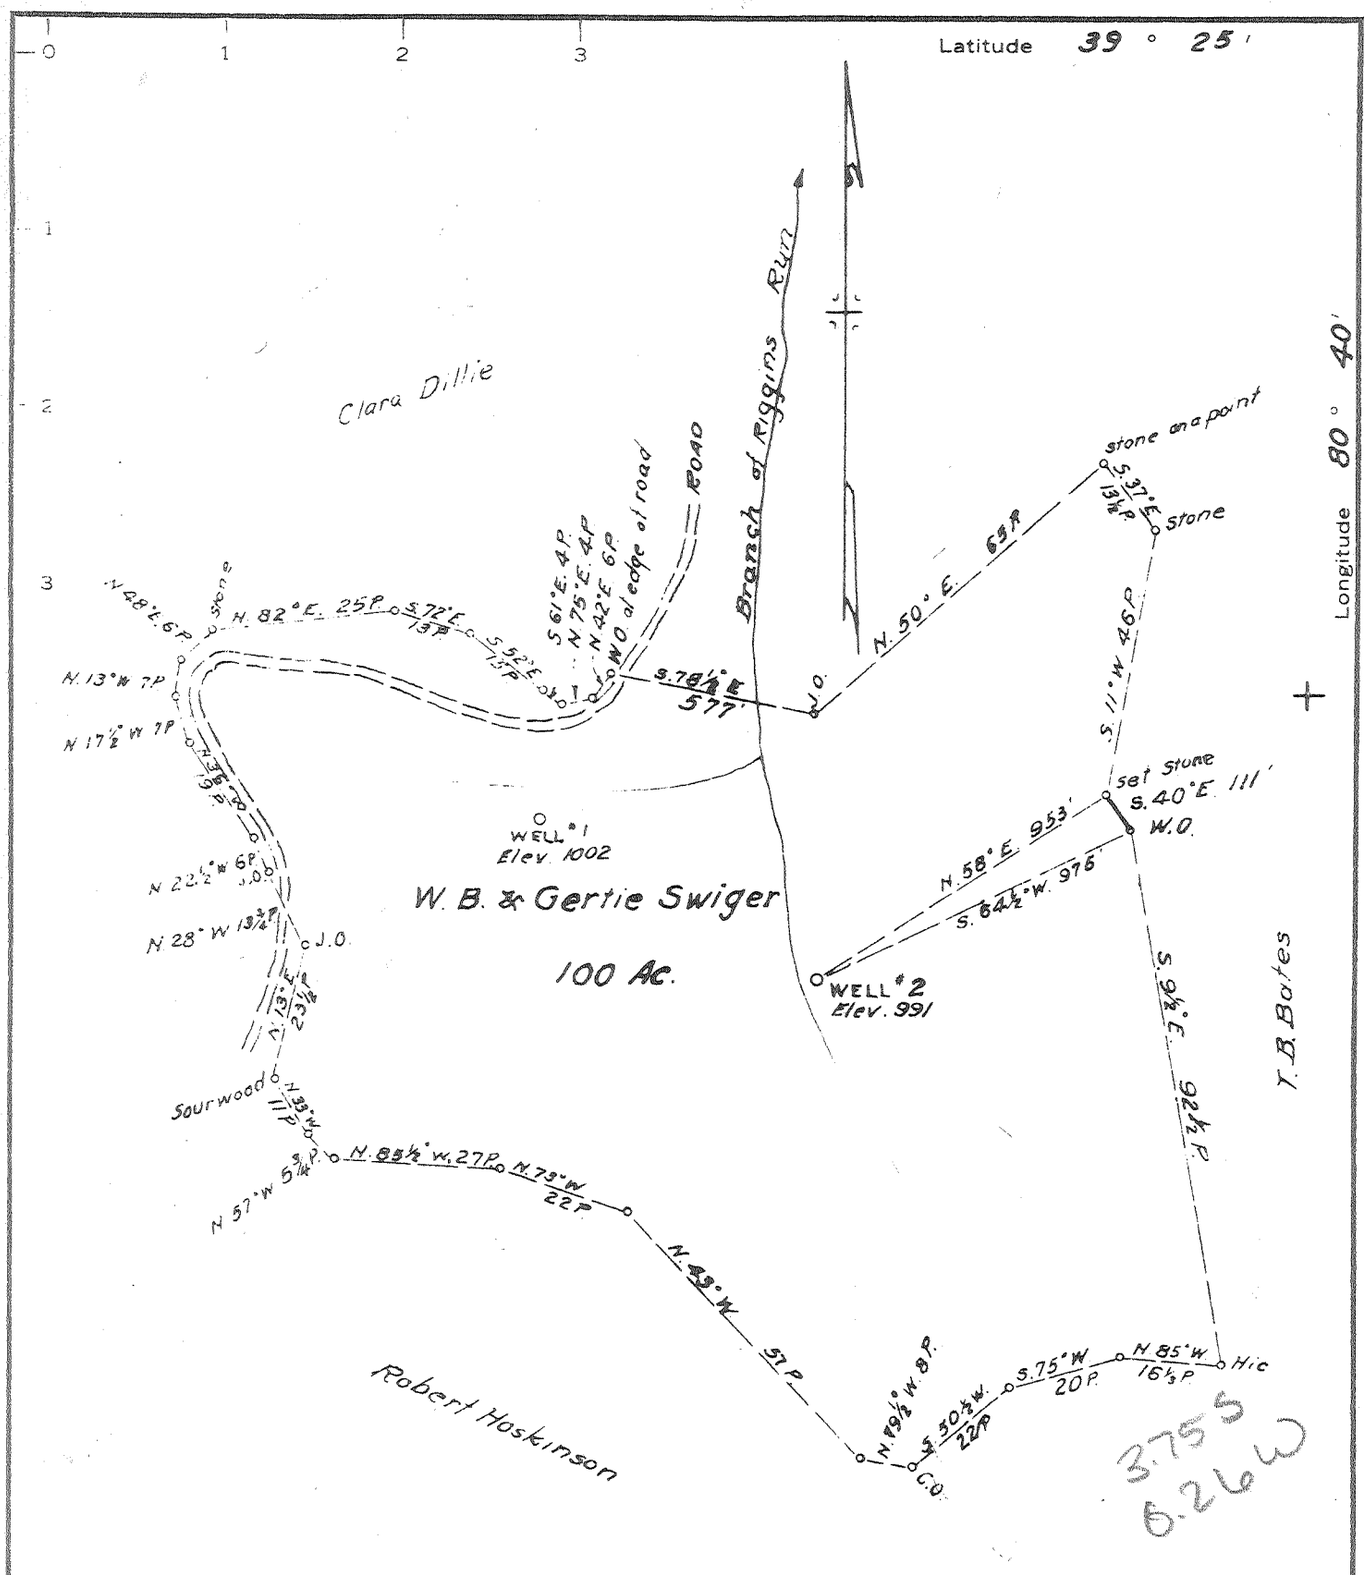

MINIMUM ERROR OF CLOSURE 1/500

SOURCE OF ELEVATION Well No 1 this farm (W B & Gertie Swiger) El. 1002

New Location X
Drill Deeper
Abandonment

"I, THE UNDERSIGNED, HEREBY CERTIFY THAT THIS MAP IS CORRECT TO THE BEST OF MY KNOWLEDGE AND BELIEF AND SHOWS ALL THE INFORMATION REQUIRED BY PARAGRAPH 6 OF THE RULES AND REGULATIONS OF THE OIL AND GAS SECTION OF THE MINING LAWS OF WEST VIRGINIA."

Company Ritchie Oil Co., R. Daugherty, Agt.
Address Pennsboro, W. Va.
Farm W. B. & Gertie Swiger
Tract 1 Acres 100 Lease No.
Well (Farm) No. 2 Serial No.
Elevation (Spirit Level) 991
Quadrangle Centerpoint WC
County Doddridge District McClellan
Engineer Parker E. Peters
Engineer's Registration No. 485
File No. Drawing No.
Date June 11, 1963 Scale 1" = 30P

STATE OF WEST VIRGINIA
DEPARTMENT OF MINES
OIL AND GAS DIVISION
CHARLESTON

WELL LOCATION MAP

FILE NO. DoD-1017

-- Denotes location of well on United States Topographic Maps, scale 1 to 62,500, latitude and longitude lines being represented by border lines as shown.

-- Denotes one inch spaces on border line of original tracing.

Stephens Blueprint and Supply Company · Parkersburg, W. Virginia