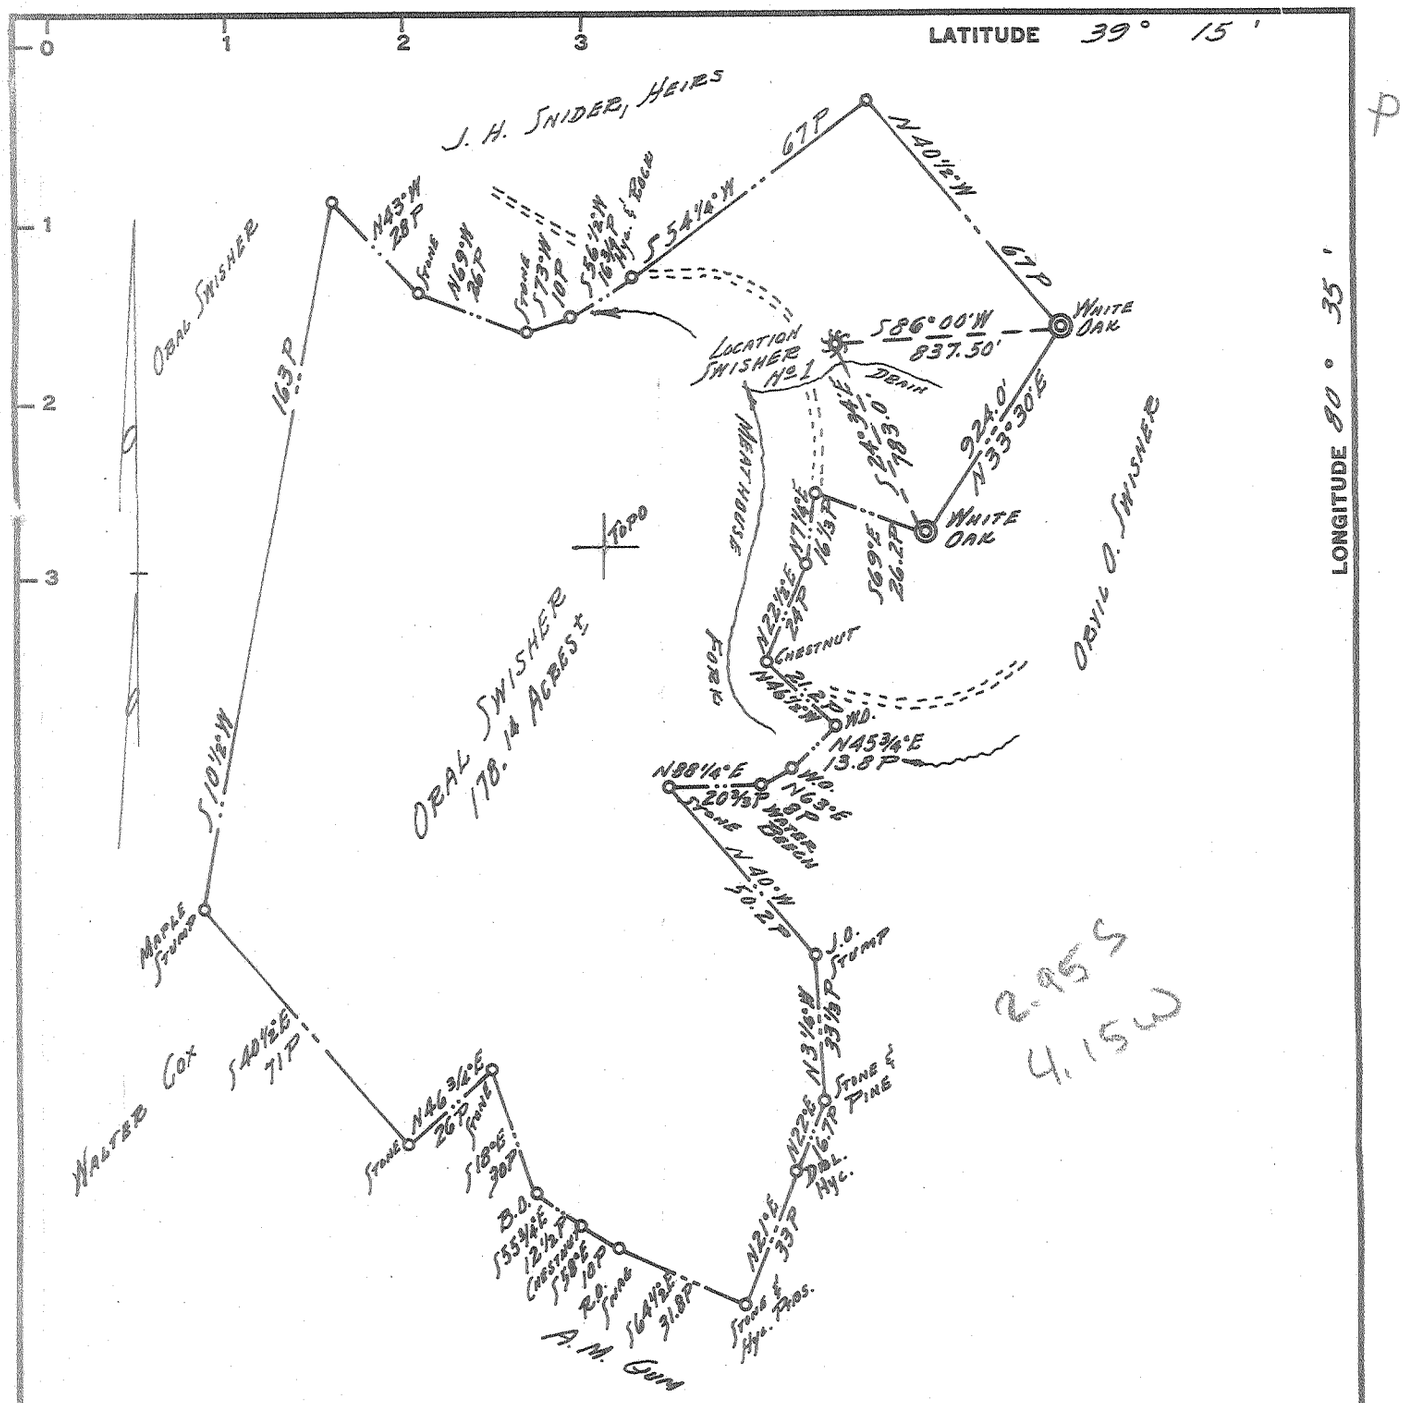

"I, THE UNDERSIGNED, HEREBY CERTIFY THAT THIS MAP IS CORRECT TO THE BEST OF MY KNOWLEDGE AND BELIEF AND SHOWS ALL THE INFORMATION REQUIRED BY PARAGRAPH 6 OF THE RULES AND REGULATIONS OF THE OIL AND GAS SECTION OF THE MINING LAWS OF WEST VIRGINIA."

By Paul G Dean

New Location..... ☒
Drill Deeper..... ☐
Abandonment..... ☐

B.M. REF.: INTERSECTION OF SNAKE RUN ROAD AT MEATHOUSE FORK ROAD .3 M.± S.E. OF LOC.
MINIMUM ERROR OF CLOSURE 1/2,000

Company GILCO OIL & GAS LTD.
Address 2104 NORA ST., PARKERSBURG, W.VA.
Farm ORAL SWISHER
Tract 1 Acres 178.14± Lease No.
Well (Farm) No. ONE Serial No.
Elevation (Spirit Level) 890
Quadrangle YADIS - NO
County DODDRIDGE District NEW MILTON
Engineer Paul G. Dean
Engineer's Registration No. 1856
File No. 136-8-8 Drawing No. 65-76
Date Nov. 8, 1965 Scale 1" = 40 P = 660'

STATE OF WEST VIRGINIA
DEPARTMENT OF MINES
OIL AND GAS DIVISION
CHARLESTON

WELL LOCATION MAP

FILE NO. DOD - 1335

+ Denotes location of well on United States Topographic Maps, scale 1 to 62,500, latitude and longitude lines being represented by border lines as shown.

— Denotes one inch spaces on border line of original tracing.

K+E IMPERIAL™ TRACING CLOTH 73575