17-02030P
09/21/2018

WW-7
8-30-06

West Virginia Department of Environmental Protection
Office of Oil and Gas
WELL LOCATION FORM: GPS

API: 47-017-02030 **WELL NO.:** WV 602081 (Charles Smith #2081)

FARM NAME: Charles Smith

RESPONSIBLE PARTY NAME: EQT Production Company

COUNTY: Doddridge **DISTRICT:** Grant

QUADRANGLE: Smithburg 7.5'

SURFACE OWNER: Connie Sue Martin

ROYALTY OWNER: Grant Family Revocable Trust

UTM GPS NORTHING: 4357489

UTM GPS EASTING: 525377 **GPS ELEVATION:** 253 m (830 ft)

The Responsible Party named above has chosen to submit GPS coordinates in lieu of preparing a new well location plat for a plugging permit or assigned API number on the above well. The Office of Oil and Gas will not accept GPS coordinates that do not meet the following requirements:

1. Datum: NAD 1983, Zone: 17 North, Coordinate Units: meters, Altitude: height above mean sea level (MSL) – meters.
2. Accuracy to Datum – 3.05 meters
3. Data Collection Method:

Survey grade GPS _____: Post Processed Differential _____
Real-Time Differential _____
Mapping Grade GPS X: Post Processed Differential X
Real-Time Differential _____

4. **Letter size copy of the topography map showing the well location.**

I the undersigned, hereby certify this data is correct to the best of my knowledge and belief and shows all the information required by law and the regulations issued and prescribed by the Office of Oil and Gas.

RECEIVED
Office of Oil and Gas
JUN 14 2018
WV Department of
Environmental Protection

Signature	Title	Date
	PS # 2180	4/26/18

17-02030 P
09/21/2018

Topo Quad: Smithburg 7.5' **Scale:** 1" = 2000'

County: Doddridge **Date:** April 26, 2018

District: Grant **Project No:** 67-30-00-08

Water

47-017-02030 WV 602081 (Charles Smith #2081)

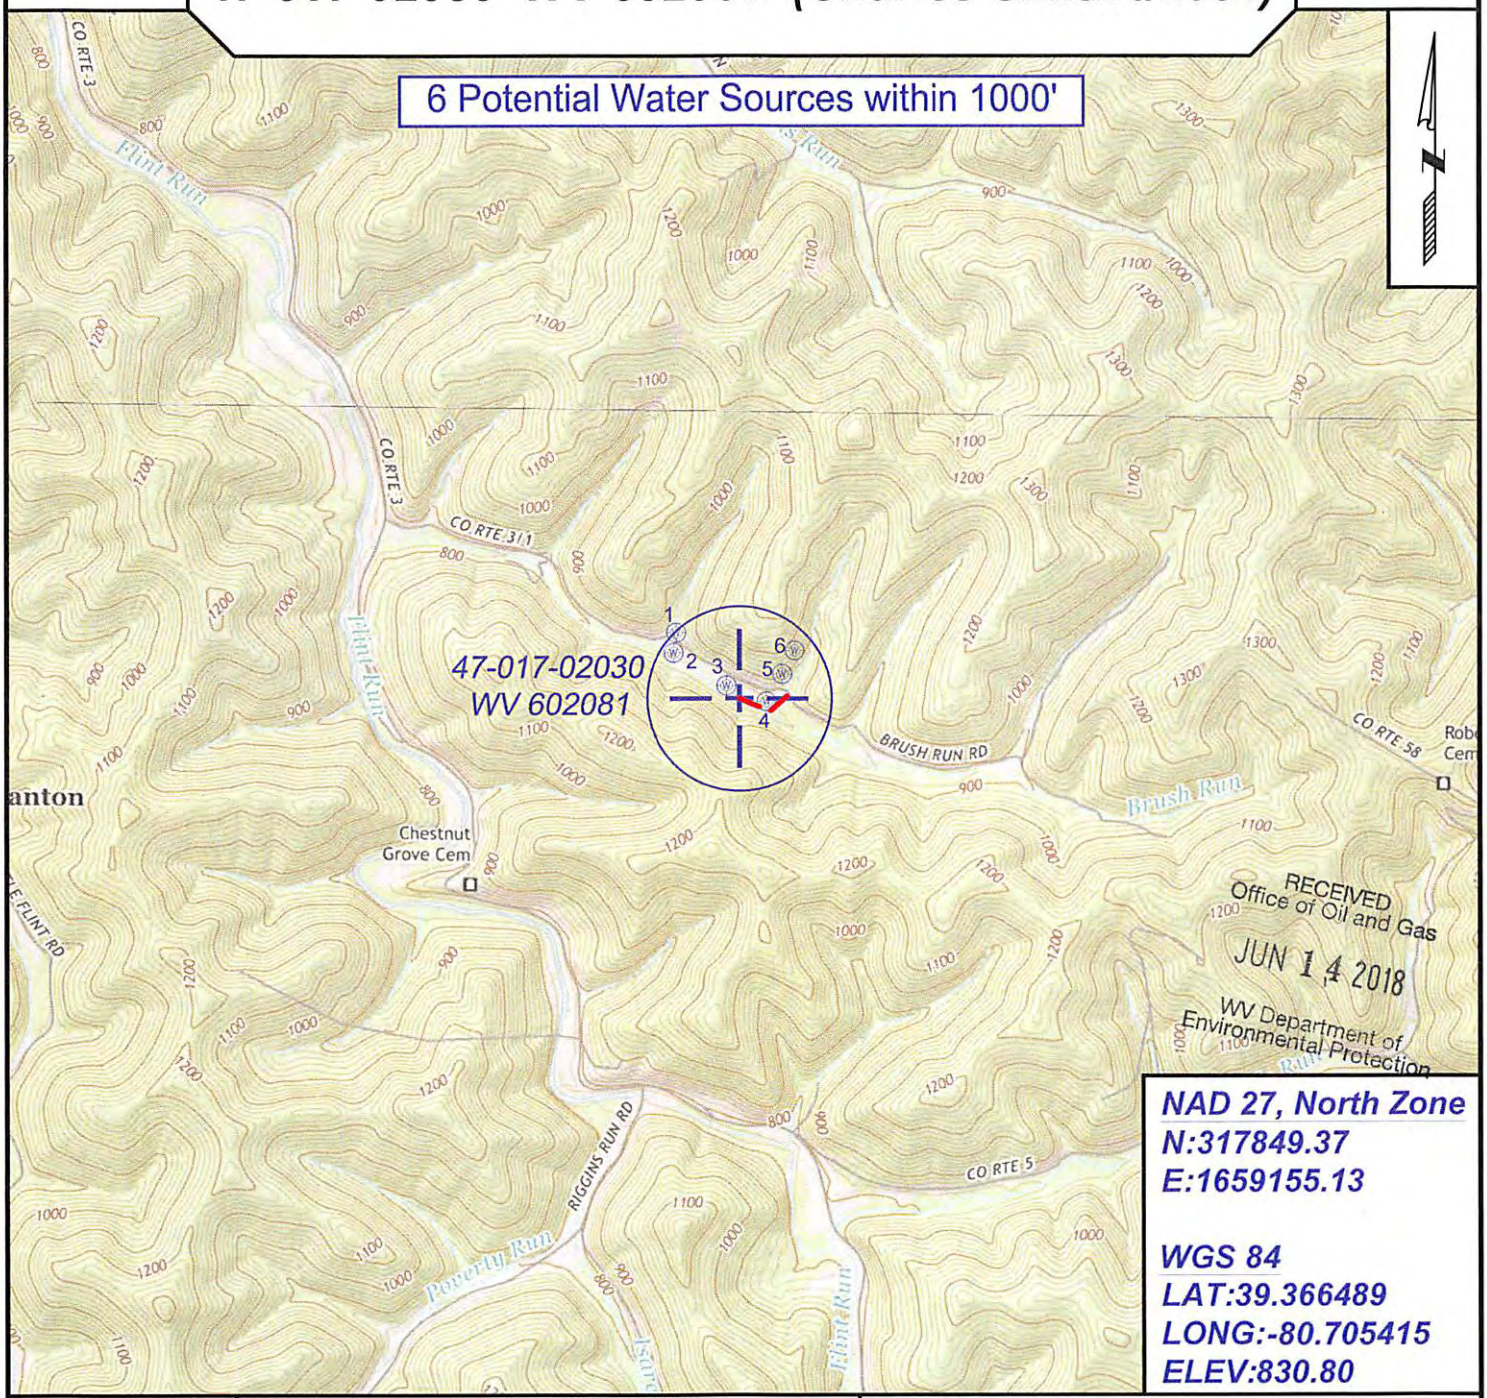

NAD 27, North Zone
N:317849.37
E:1659155.13

WGS 84
LAT:39.366489
LONG:-80.705415
ELEV:830.80

SURVEYING AND MAPPING SERVICES PERFORMED BY:

ALLEGHENY SURVEYS, INC.

1-800-482-8606
237 Birch River Road
Birch River, WV 26610
PH: (304) 649-8606
FAX: (304) 649-8608

PREPARED FOR:

EQT Production Company

2400 Ansys Drive
Canonsburg, PA 15317