

(+) DENOTES LOCATION OF WELL ON UNITED STATES TOPOGRAPHIC MAPS

FILE NO. _____
 DRAWING NO. 1
 SCALE 1" = 1000'
 MINIMUM DEGREE OF ACCURACY 1 in 200
 PROVEN SOURCE OF ELEVATION Spot elev 398'
SE of Location: elev 1055

I THE UNDERSIGNED, HEREBY CERTIFY THAT THIS PLAT IS CORRECT TO THE BEST OF MY KNOWLEDGE AND BELIEF AND SHOWS ALL THE INFORMATION REQUIRED BY LAW AND THE REGULATIONS ISSUED AND PRESCRIBED BY THE DEPARTMENT OF ENERGY.
 (SIGNED) David S Jackson
 R.P.E. _____ L.L.S. 708



STATE OF WEST VIRGINIA
 Division of Environmental Protection
 OFFICE OF OIL AND GAS

DATE July 10, 19 98
 OPERATOR'S WELL NO. 4662
 API WELL NO. _____

WELL TYPE: OIL _____ GAS X LIQUID INJECTION _____ WASTE DISPOSAL _____
 (IF "GAS,") PRODUCTION X STORAGE _____ DEEP _____ SHALLOW X

LOCATION: ELEVATION 1076 WATERSHED Straight Fork **PLUG. CANCELLED**
 DISTRICT Southwest COUNTY Doddridge
 QUADRANGLE Oxford

SURFACE OWNER Arden E. & Carol L. Cogar ACREAGE 252
 OIL & GAS ROYALTY OWNER John F. Smith, et als. LEASE ACREAGE 2000
 LEASE NO. 9481

PROPOSED WORK: DRILL _____ CONVERT _____ DRILL DEEPER _____ REDRILL _____ FRACTURE OR STIMULATE _____ PLUG OFF OLD FORMATION _____ PERFORATE NEW FORMATION _____ OTHER PHYSICAL CHANGE IN WELL (SPECIFY) _____

PLUG AND ABANDON X CLEAN OUT AND REPLUG _____
 TARGET FORMATION 2nd salt sands ESTIMATED DEPTH 1674
 WELL OPERATOR Equitrans, L.P. DESIGNATED AGENT William Hostuller
 ADDRESS 3500 Park Lane Pittsburgh, PA. 15275 ADDRESS P.O. Box 1550 Clarksburg, WV 26301

*Plugged
 1929 well
 Drilled in 1978*

COUNTY NAME Dodd
 PERMIT 2053 PLAN 1

FEB 15 2002

Rev (5-01)
WR-38

DATE: 03/24/06

API#

47-047-02063

17-02053

STATE OF WEST VIRGINIA
DEPARTMENT OF ENVIRONMENTAL PROTECTION
OFFICE OF OIL AND GAS

AFFIDAVIT OF PLUGGING AND FILLING WELL

AFFIDAVIT SHOULD BE IN TRIPLICATE, one copy mailed to the Department, one copy to be retained by the Well Operator and the third copy (and extra copies if required) should be mailed to each coal operator at their respective addresses.

Farm name: Cogar, Arden+

Operator Well No.: Cogar 4662

LOCATION: Elevation: 1076
District: Southwest
Latitude: Feet South of _____ Deg. _____ Min. _____ Sec. _____
Longitude: Feet West of _____ Deg. _____ Min. _____ Sec. _____

Quadrangle: Oxford
County: Doddridge

Well Type: OIL X GAS _____

Company: Equitable Production Company
1710 Pennsylvania Avenue
Charleston, WV 25302

Coal Operator or Owner _____
Coal Operator or Owner _____

Agent: Steven G. Perdue

Permit Issued Date: 8/9/2005

AFFIDAVIT

STATE OF WEST VIRGINIA,

County of Doddridge ss:

Kyle D. Perkins and Carl McQuillian being first duly sworn according to law depose and say that they are experienced in the work of plugging and filling oil and gas wells and were employed by the above named well operator, and participated in the work of plugging and filling the above well, and Mike Underwood Oil and Gas Inspector representing the Secretary, say that said work was commenced on the 15th day of March, 2006, and that the well was plugged and filled in the following manner:

TYPE	FROM	TO	PIPE REMOVED		LEFT
Cement	1506	1356	3 1/2	1506	168
Gel	1356	950			
Cement	950	850	8	212	688
Gel	850	600	10	104	56
Cement	600	500			
Gel	500	220			
Cement	220	surface			

Description of monument: 8" casing extending 30" above surface and that the work of plugging and filling said well was completed on the 23rd day of March, 2006.
And further deponents saith not. Kyle Perkins

Sworn and subscribed before me this 24th day of March, 2006

My commission expires: June 3, 2006
June 7, 2010

[Signature]
Notary Public

Oil and Gas Inspector: [Signature] 3/28/06

OFFICIAL SEAL
NOTARY PUBLIC, STATE OF WEST VIRGINIA
CURTIS A. LUCAS
P.O. BOX 4652
PARKERSBURG, WV 25104
MY COMMISSION EXPIRES JUNE 7, 2010

RECEIVED
Office of Oil & Gas
Office of Chief
JUN 12 2006
WV Department of
Environmental Protection

JUN 16 2006

0000 2053



West Virginia Department of Environmental Protection
Office of Oil and Gas
WELL LOCATION FORM: GPS

API: 47-017-2053^P

WELL NO.: WV 604662 (4662)

FARM NAME: Arden Cogar

RESPONSIBLE PARTY NAME: Equitable Production Company

COUNTY: Doddridge

DISTRICT: Southwest

QUADRANGLE: Oxford 7.5'

SURFACE OWNER: Arden and Carol Cogar

ROYALTY OWNER: John F. Smith et al

UTM GPS NORTHING: 4332768

UTM GPS EASTING: 515599

GPS ELEVATION: 329

The Responsible Party named above has chosen to submit GPS coordinates in lieu of preparing a new well location plat for a plugging permit on the above well. The Office of Oil and Gas will not accept GPS coordinates that do not meet the following requirements:

1. Datum: NAD 1983, Zone: 17 North, Coordinate Units: meters, Altitude: height above mean sea level (MSL) – meters.
2. Accuracy to Datum – 3.05 meters
3. Data Collection Method:

Survey grade GPS _____: Post Processed Differential _____
Real-Time Differential _____

Mapping Grade GPS X: Post Processed Differential X
Real-Time Differential _____


I the undersigned, hereby certify this data is correct to the best of my knowledge and belief and shows all the information required by law and the regulations issued and prescribed by the Office of Oil and Gas.

Gregory A. Smith

Gregory A. Smith, P. S. 677 President, Smith Land Surveying, Inc

7-13-05

Date

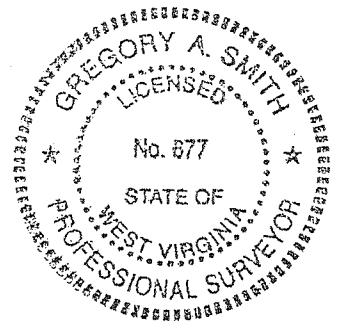

D000 2053 P

AUG 12 2005