

1703649P

WW-7
8-30-06



West Virginia Department of Environmental Protection
Office of Oil and Gas

WELL LOCATION FORM: GPS

API: 47-017-03649 WELL NO.: Perkins 14

FARM NAME: Antero Resources Corporation

RESPONSIBLE PARTY NAME: Antero Resources Corporation

COUNTY: Doddridge DISTRICT: Central

QUADRANGLE: Pennsboro

SURFACE OWNER: Antero Resources Corporation

ROYALTY OWNER: W.A. Flanagan et al

UTM GPS NORTHING: 4346253.872

UTM GPS EASTING: 508041.644 GPS ELEVATION: 1011'

The Responsible Party named above has chosen to submit GPS coordinates in lieu of preparing a new well location plat for a plugging permit or assigned API number on the above well. The Office of Oil and Gas will not accept GPS coordinates that do not meet the following requirements:

1. Datum: NAD 1983, Zone: 17 North, Coordinate Units: meters, Altitude: height above mean sea level (MSL) – meters.
2. Accuracy to Datum – 3.05 meters
3. Data Collection Method:

Survey grade GPS : Post Processed Differential _____
Real-Time Differential

Mapping Grade GPS _____ : Post Processed Differential _____
Real-Time Differential _____

4. Letter size copy of the topography map showing the well location.

I the undersigned, hereby certify this data is correct to the best of my knowledge and belief and shows all the information required by law and the regulations issued and prescribed by the Office of Oil and Gas.

Ashley Steele
Signature

Permitting Supervisor
Title


12/5/2016
Date

RECEIVED
Office of Oil and Gas

DEC 19 2016

WV Department of
Environmental Protection

12/29/2016

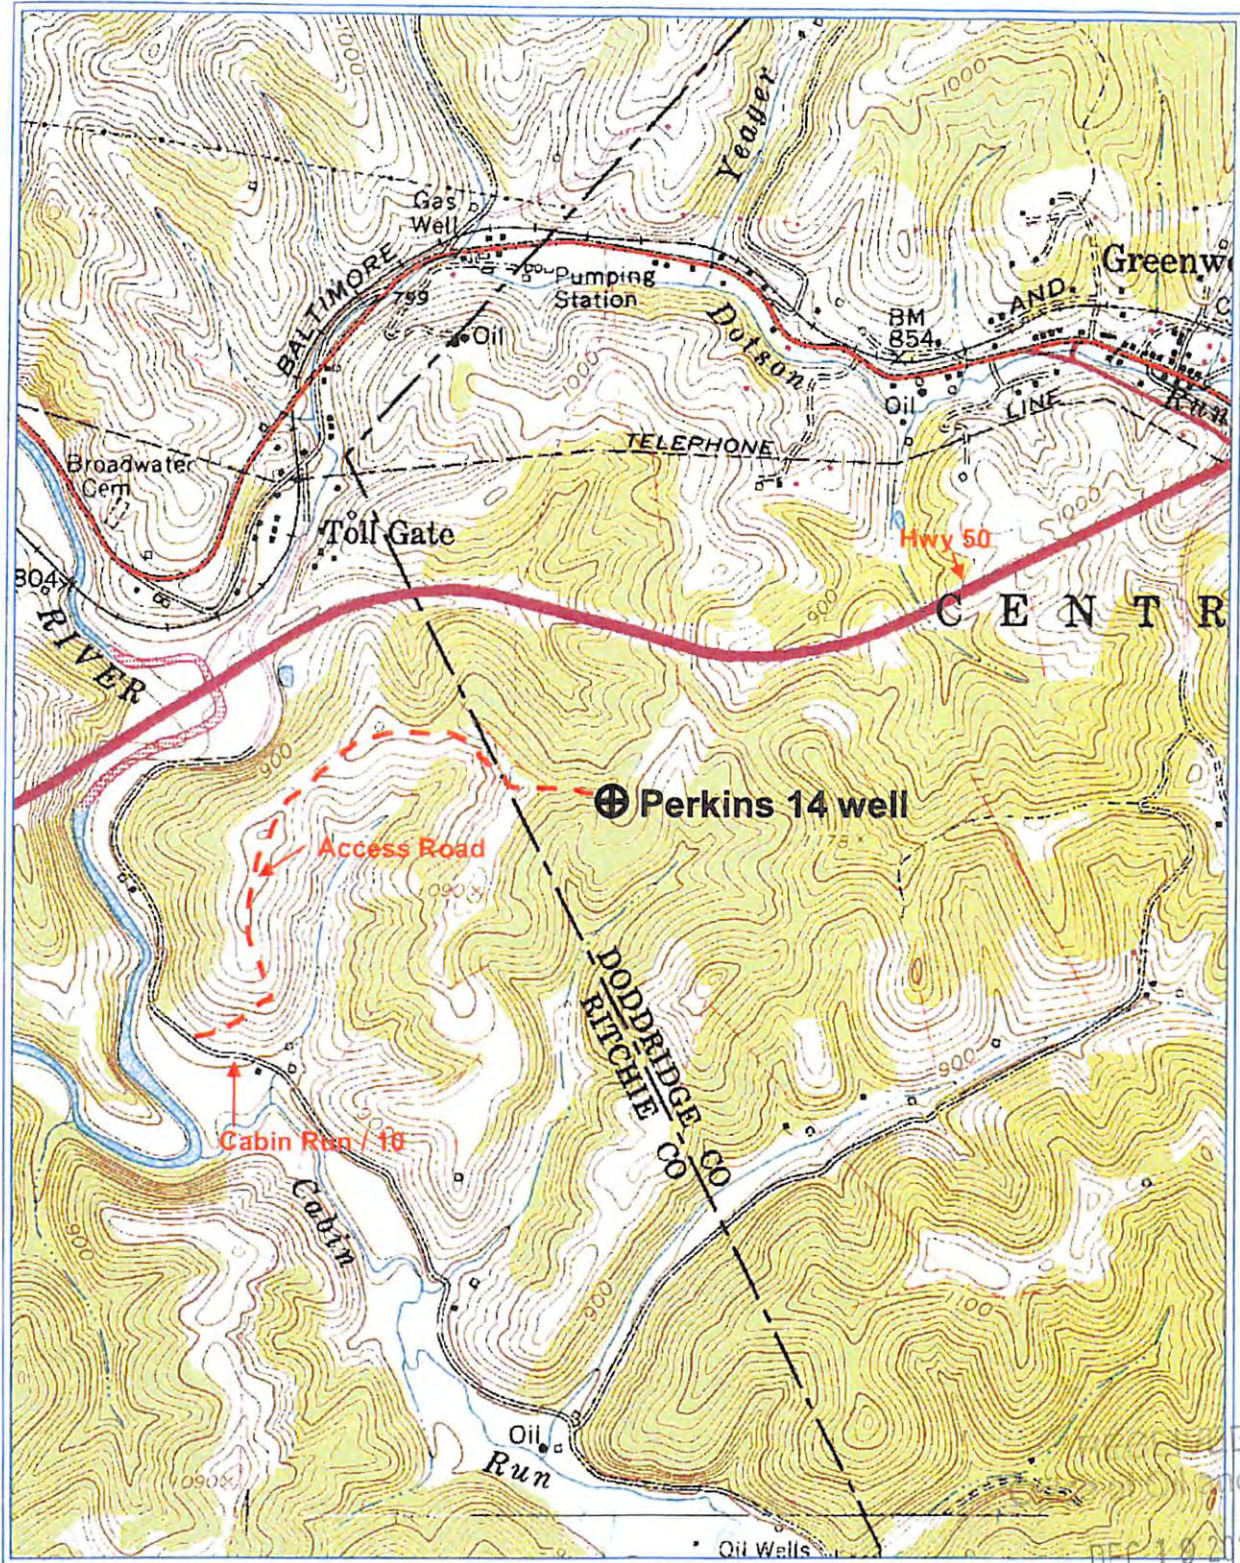

Antero Resources Corporation
 Appalachian Basin Environmental Protection
 Perkins 14
 Doddridge County

Quadrangle: Pennsboro
 Watershed: Cabin Run
 District: Central
 Date: 11-01-2016