FORM WR-6

STATE OF WEST VIRGINIA

REPRESENTED BY THE

WEST VIRGINIA GEOLOGICAL SURVEY

AND OTHER STATE AGENCIES

STATE OF WELLONS

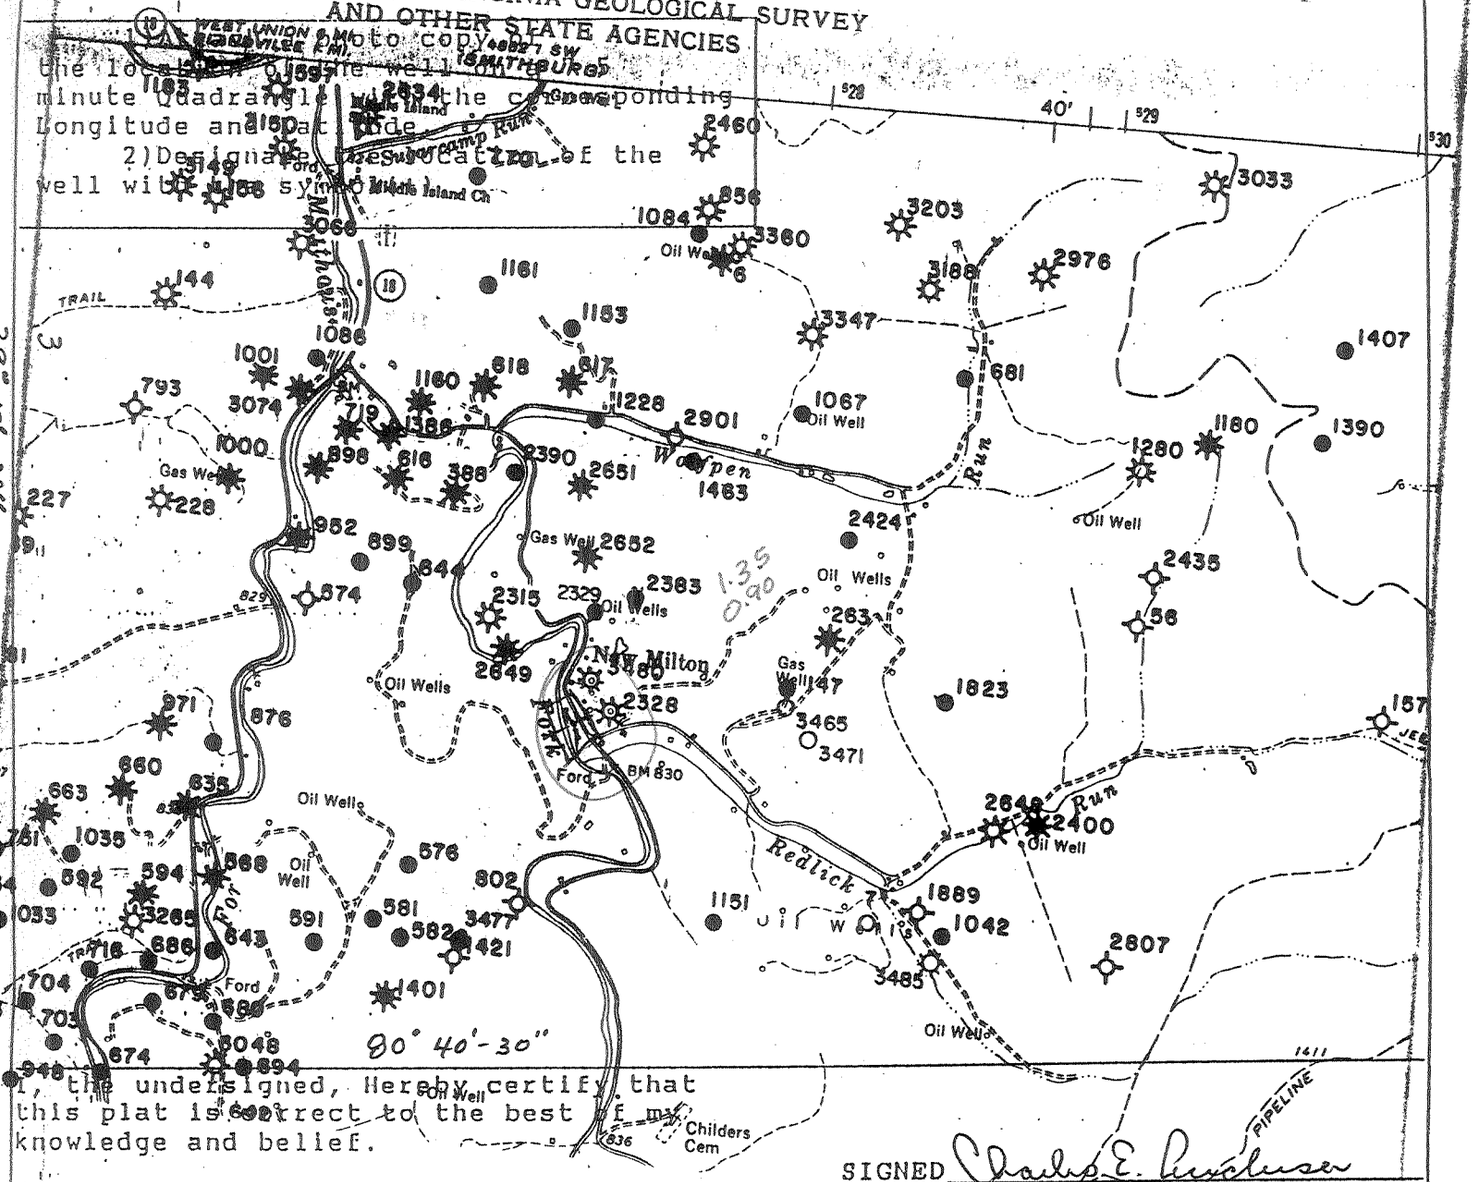

the location of the well on a United States topographic map, minute quadrangle map, showing the corresponding Longitude and Latitude lines.

2) Designate the location of the well with a symbol.

I, the undersigned, hereby certify that this plat is correct to the best of my knowledge and belief.

SIGNED Charles E. Anderson

TITLE VICE PRESIDENT

DATE AUGUST 21, 19 90

OPERATORS WELL NO. 1

API WELL NO. 13

STATE OF WEST VIRGINIA
DEPARTMENT OF ENERGY
OIL AND GAS DIVISION

017-3931

WELL TYPE: OIL X GAS ____ LIQUID INJECTION ____ WASTE DISPOSAL ____
(IF "GAS" PRODUCTION ____ STORAGE ____ DEEP ____ SHALLOW ____

LOCATION: ELEVATION 830 WATER SHED MEATHOUSE FORK
DISTRICT NEW MILTON COUNTY DODDRIDGE
QUADRANGLE NEW MILTON

SURFACE OWNER DON REPERT ACREAGE 1

OIL & GAS ROYALTY OWNER L.F. RANDOLPH HEIRS LEASE ACREAGE 1
LEASE NO. 11

PRODUCING FORMATION BIG INJUN TOTAL DEPTH 2000

WELL OPERATOR DILMUR OIL COMPANY DESIGNATED AGENT CHARLES E. ANDERSON
ADDRESS CENTERPOINT STAR ROUTE BOX 165 WEST UNION, W.Va. 26456 ADDRESS SAME

L. F. Randolph.

(11)