✓ 39 12 30

LATITUDE

80 00

0 0.87 0.62

LONGITUDE

7'5 OGIS topo location

7.5' loc _____ 15' loc (calc.) _____

Company _____

Farm _____

Quad _____

County _____

District _____

WELL LOCATION MAP

File No. 017 3939

FORM WR-6

INSTRUCTIONS

1) Attach a photo copy of the location of the well on a 7.5 minute Quadrangle with the corresponding Longitude and Latitude.

2) Describe the location of the well with the [illegible]

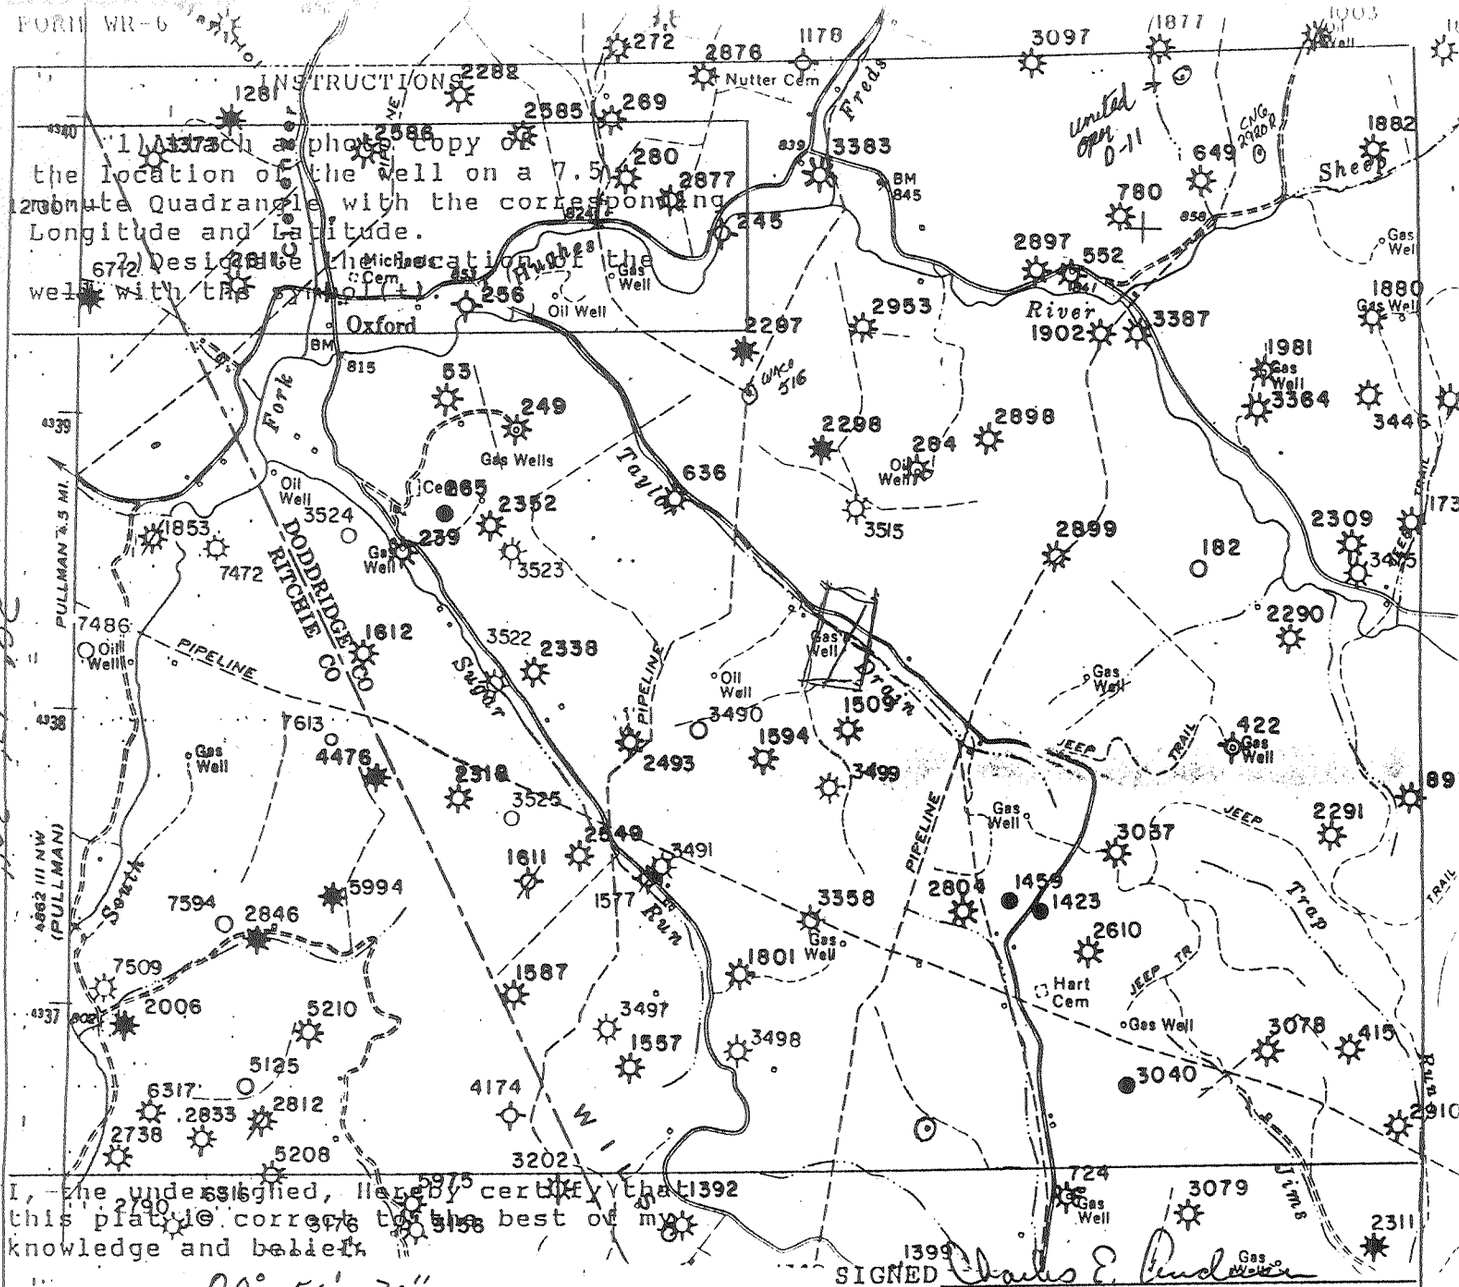

I, the undersigned, hereby certify that this plat is correct to the best of my knowledge and belief.

80°-50'-30"

SIGNED Charles E. Anderson

TITLE VICE PRESIDENT

DATE AUGUST 21, 19 90

OPERATORS WELL NO. 1

API WELL NO. 017-3939

STATE OF WEST VIRGINIA
DEPARTMENT OF ENERGY
OIL AND GAS DIVISION

WELL TYPE: OIL ____ GAS x LIQUID INJECTION ____ WASTE DISPOSAL ____
(IF "GAS" PRODUCTION ____ STORAGE ____ DEEP ____ SHALLOW x

LOCATION: ELEVATION 910 WATER SHED TAYLER DRAIN
DISTRICT SOUTHWEST COUNTY DODDRIDGE
QUADRANGLE OXFORD

SURFACE OWNER ROBERT SNYDER ACREAGE 153

OIL & GAS ROYALTY OWNER ROSCO SCOTT HEIRS LEASE ACREAGE 153
LEASE NO. 12

PRODUCING FORMATION BIG INJUN TOTAL DEPTH 2000

WELL OPERATOR DILMUR OIL COMPANY DESIGNATED AGENT CHARLES E. ANDERSON
ADDRESS CENTERPOINT STAR ROUTE BOX 165 WEST UNION, W.Va. 26456 ADDRESS SAME

Rosco Scott

(12)