FORM WW 6

BALL LEASE
120 ACRES±
WELL NO. 1

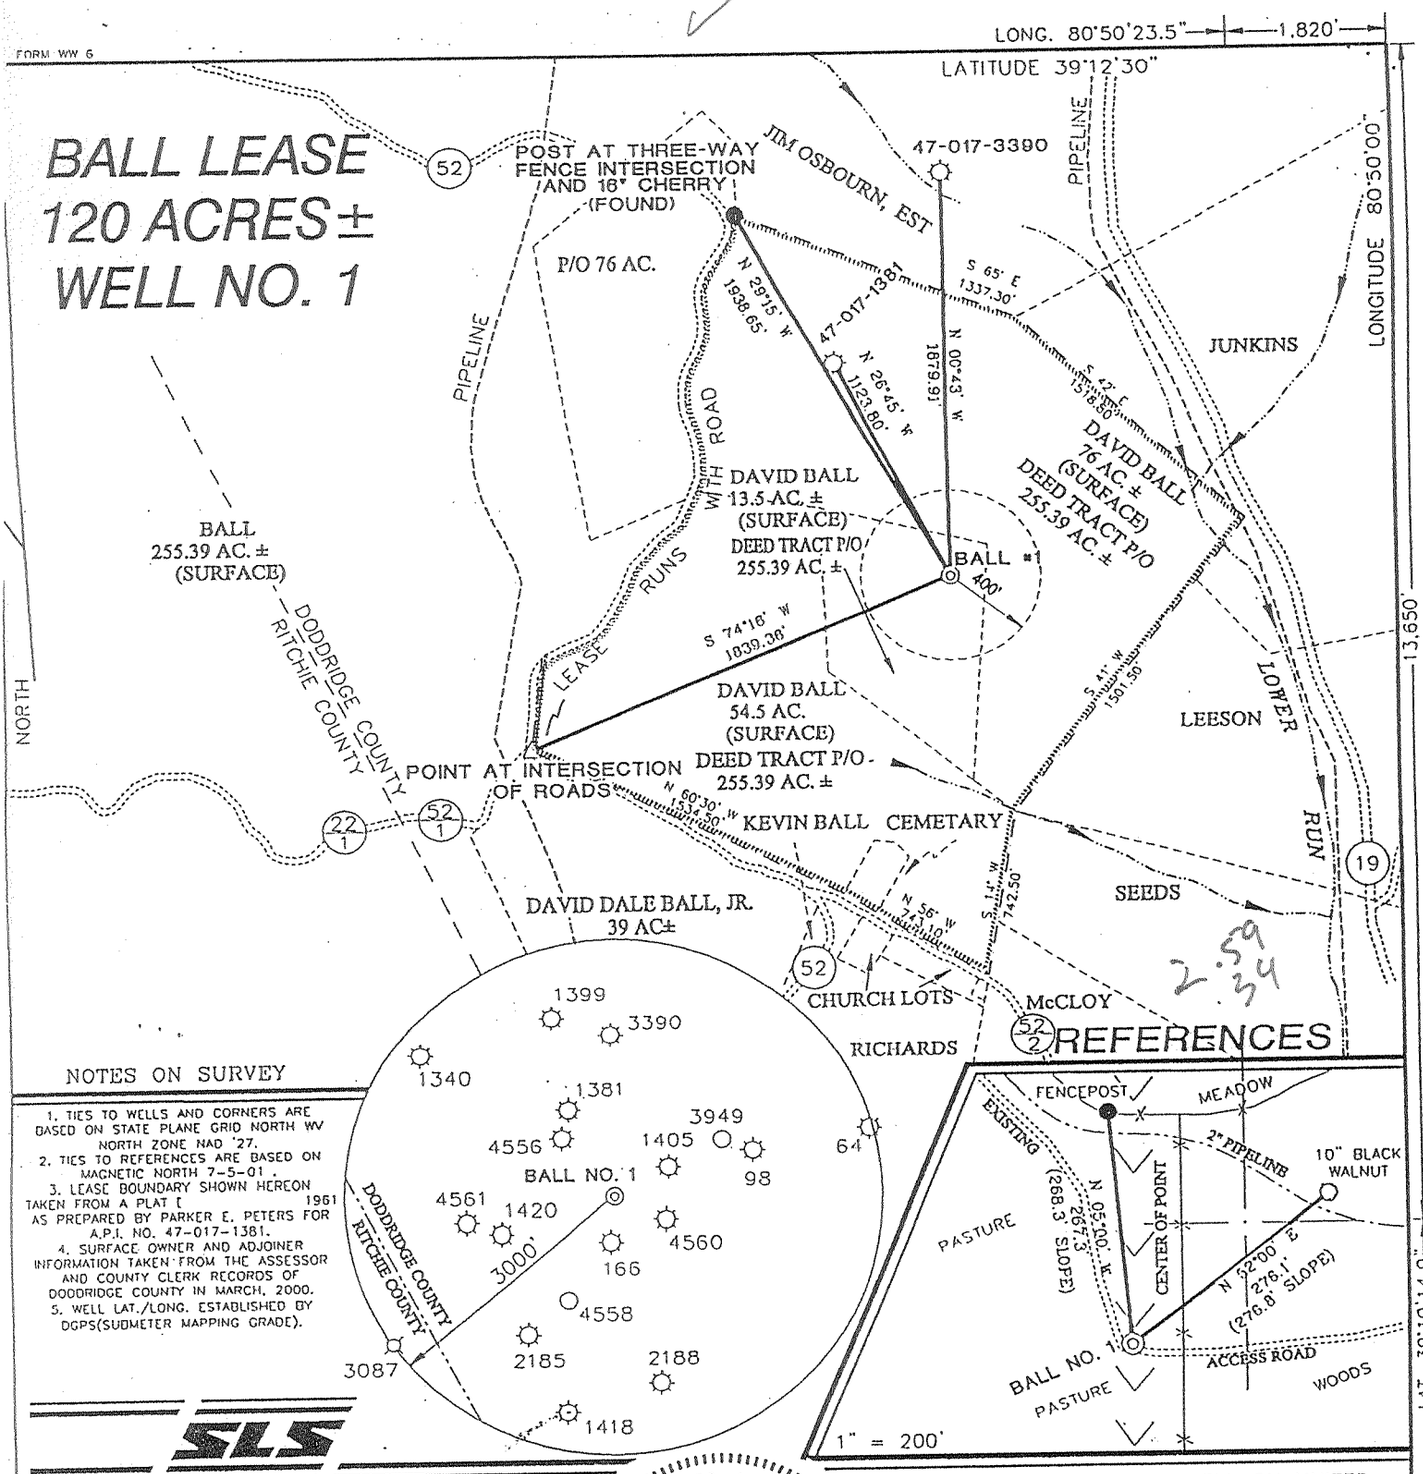

NOTES ON SURVEY

1. TIES TO WELLS AND CORNERS ARE BASED ON STATE PLANE GRID NORTH WV NORTH ZONE NAD '27.
2. TIES TO REFERENCES ARE BASED ON MAGNETIC NORTH 7-5-01 .
3. LEASE BOUNDARY SHOWN HEREON TAKEN FROM A PLAT [1961 AS PREPARED BY PARKER E. PETERS FOR A.P.I. NO. 47-017-1381.
4. SURFACE OWNER AND ADJOINER INFORMATION TAKEN FROM THE ASSESSOR AND COUNTY CLERK RECORDS OF DODDRIDGE COUNTY IN MARCH, 2000.
5. WELL LAT./LONG. ESTABLISHED BY DGPS(SUBMETER MAPPING GRADE).

SLS

I THE UNDERSIGNED, HEREBY CERTIFY THAT THIS PLAT IS CORRECT TO THE BEST OF MY KNOWLEDGE AND BELIEF AND SHOWS ALL THE INFORMATION REQUIRED BY LAW AND THE REGULATIONS ISSUED AND PRESCRIBED BY THE DIVISION OF ENVIRONMENTAL PROTECTION.

P.S. 677 Gregory A. Smith

GREGORY A. SMITH LICENSED No. 677 STATE OF WEST VIRGINIA PROFESSIONAL SURVEYOR

(+) DENOTES LOCATION OF WELL ON UNITED STATES TOPOGRAPHIC MAPS.

DATE JULY 17, 20 01

OPERATORS WELL NO. BALL #1

API WELL NO. 47 (STATE) - 017 (COUNTY) - 04635 (PERMIT)

MINIMUM DEGREE OF ACCURACY 1 / 200 PROVEN SOURCE OF ELEVATION JUNCTION OF ROADS 1091'

FILE NO. 4389AP1 (104-45) SCALE 1"= 800'

STATE OF WEST VIRGINIA
DIVISION OF ENVIRONMENTAL PROTECTION
OFFICE OF OIL AND GAS

WELL TYPE : OIL ___ GAS X LIQUID INJECTION ___ WASTE DISPOSAL ___ IF "GAS" PRODUCTION X STORAGE ___ DEEP X SHALLOW ___

LOCATION :
ELEVATION 1058' WATERSHED TRIBUTARY OF LOWER RUN
DISTRICT SOUTHWEST COUNTY DODDRIDGE QUADRANGLE OXFORD 7.5'
SURFACE OWNER DAVID BALL AND JANICE BALL ACREAGE 13.5 OF 255.39
ROYALTY OWNER DAVID DALE BALL, ET AL LEASE ACREAGE 120
PROPOSED WORK : LEASE NO. ___
DRILL X CONVERT ___ DRILL DEEPER ___ REDRILL ___ FRACTURE OR STIMULATE X PLUG OFF OLD FORMATION ___ PERFORATE NEW FORMATION ___ PLUG AND ABANDON ___ CLEAN OUT AND REPLUG ___ OTHER ___
PHYSICAL CHANGE IN WELL (SPECIFY) ___ TARGET FORMATION BASEMENT
ESTIMATED DEPTH 21,000

WELL OPERATOR BETRO, INC. DESIGNATED AGENT WILLIAM R. STALNAKER
ADDRESS RT. 77 BOX 7-T, GLENVILLE, WV 26351 ADDRESS RT. 77 BOX 7-T, GLENVILLE, WV 26351

COUNTY NAME BRA

PERMIT 4635

AUG 31 2001