

WW-7  
8-30-06



West Virginia Department of Environmental Protection  
Office of Oil and Gas  
**WELL LOCATION FORM: GPS**

API: 47-017-05400 WELL NO.: 7192REV  
 FARM NAME: Moose, Gene & Linda  
 RESPONSIBLE PARTY NAME: Antero Resources Corporation  
 COUNTY: Doddridge DISTRICT: West Union  
 QUADRANGLE: Smithburg  
 SURFACE OWNER: Gene P & Linda G Moose  
 ROYALTY OWNER: Consol Gas Company  
 UTM GPS NORTHING: 4347749.41 m  
 UTM GPS EASTING: 523673.0 m GPS ELEVATION: 355.1 m (1165')

The Responsible Party named above has chosen to submit GPS coordinates in lieu of preparing a new well location plat for a plugging permit or assigned API number on the above well. The Office of Oil and Gas will not accept GPS coordinates that do not meet the following requirements:

- Datum: NAD 1983, Zone: 17 North, Coordinate Units: meters, Altitude: height above mean sea level (MSL) – meters.
- Accuracy to Datum – 3.05 meters
- Data Collection Method:

Survey grade GPS  : Post Processed Differential \_\_\_\_\_  
 Real-Time Differential

Mapping Grade GPS  : Post Processed Differential \_\_\_\_\_  
 Real-Time Differential

- Letter size copy of the topography map showing the well location.**


I the undersigned, hereby certify this data is correct to the best of my knowledge and belief and shows all the information required by law and the regulations issued and prescribed by the Office of Oil and Gas.

Mam Sta Signature Permitting Supervisor Title 10/24/17 Date

RECEIVED  
Office of Oil and Gas  
OCT 25 2017  
WV Department of  
Environmental Protection

01/19/2018



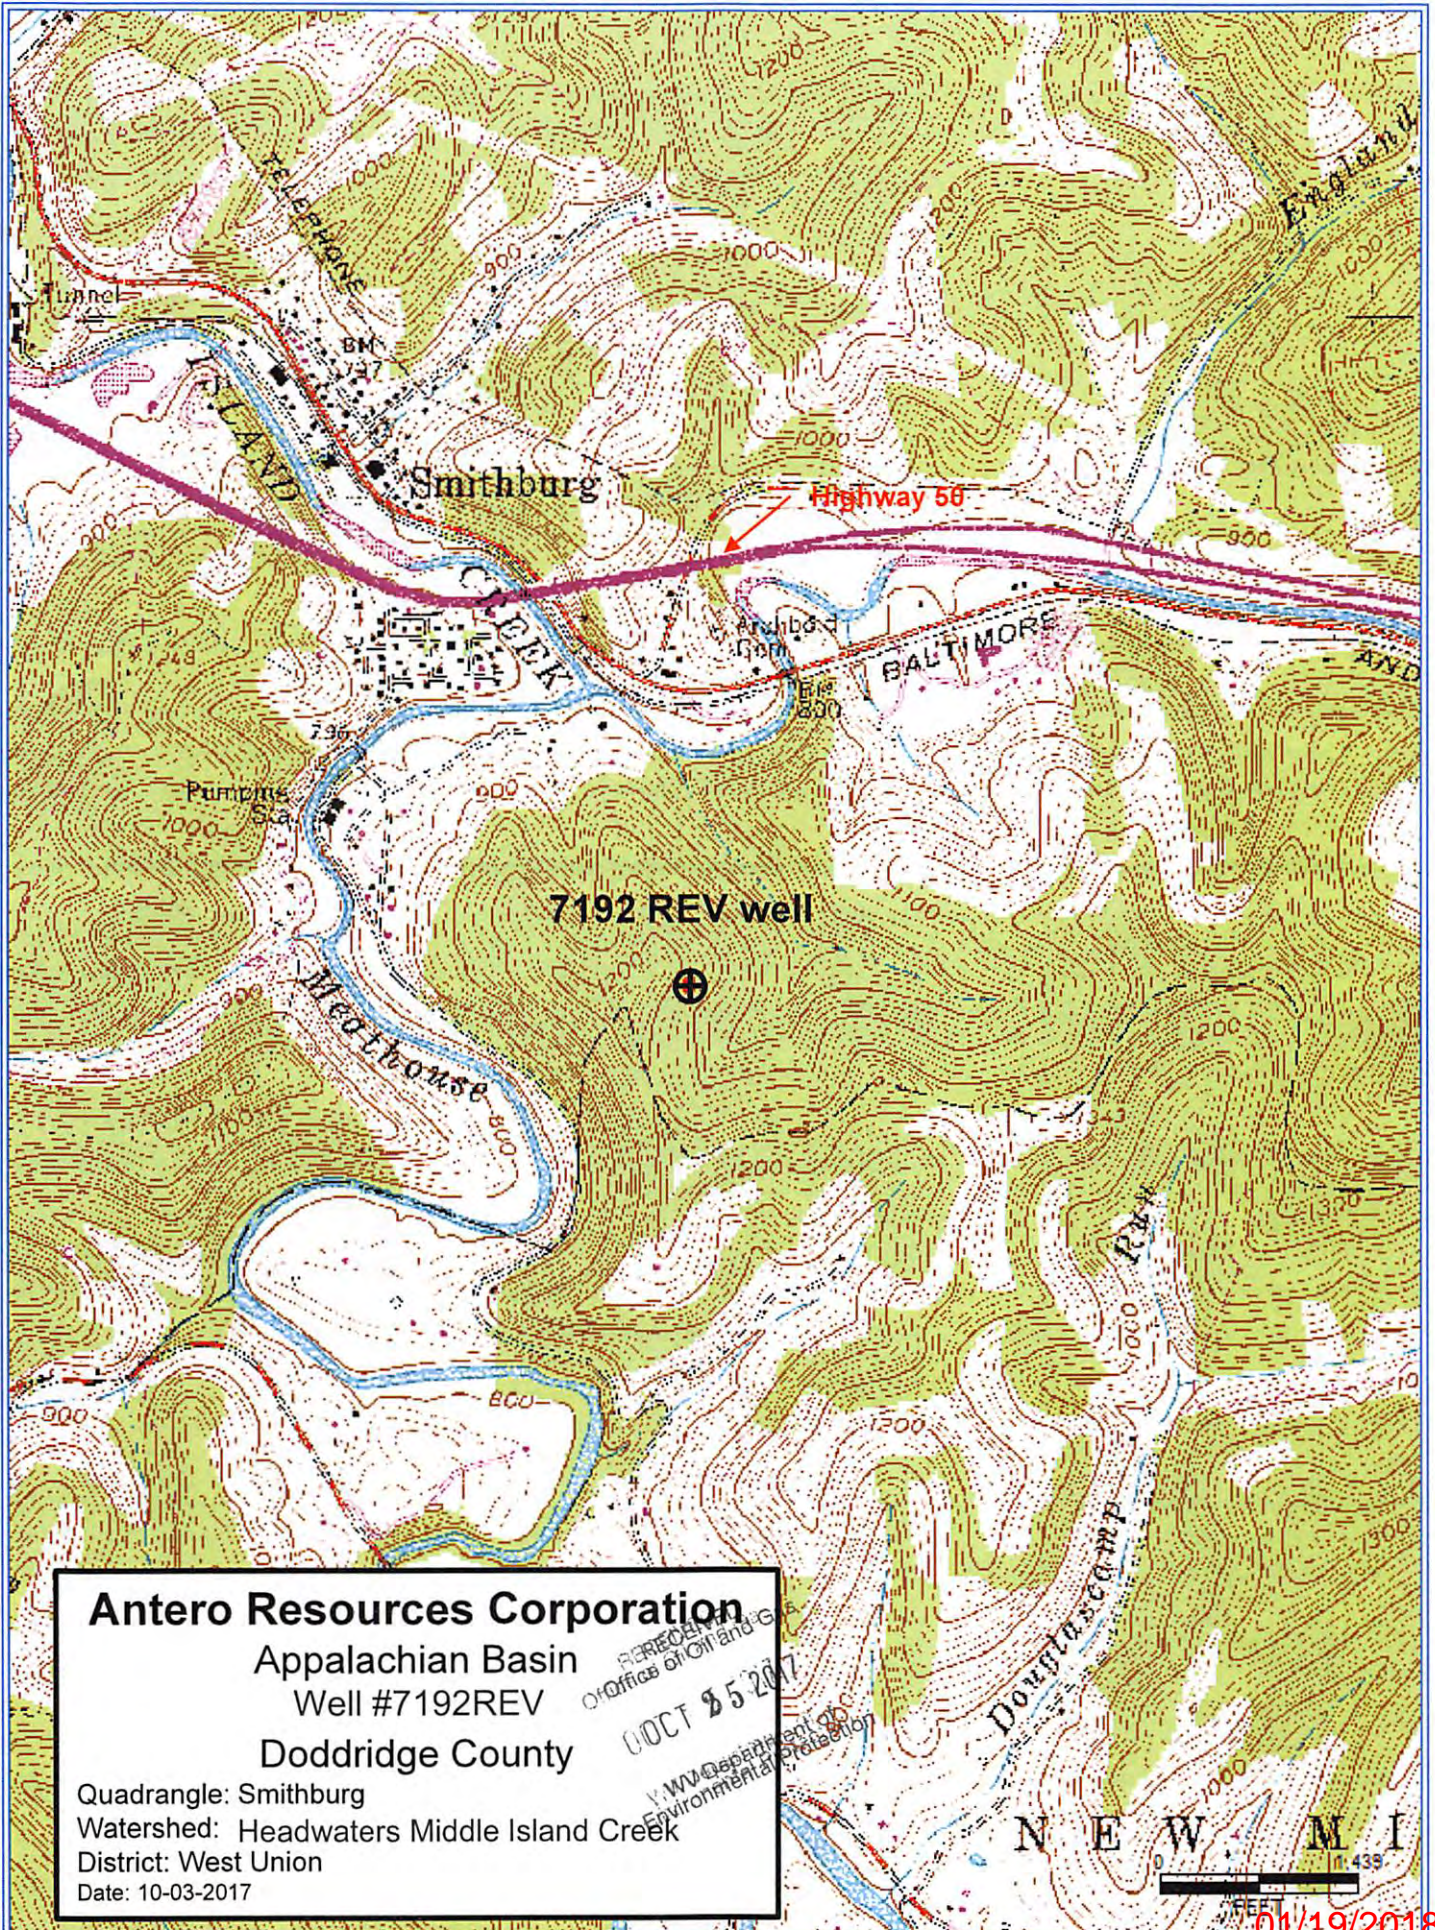

**Antero Resources Corporation**  
 Appalachian Basin  
 Well #7192REV  
 Doddridge County

Quadrangle: Smithburg  
 Watershed: Headwaters Middle Island Creek  
 District: West Union  
 Date: 10-03-2017

RECEIVED BY  
 Office of Oil and Gas  
 OCT 8 5 2017  
 WV Department of Environmental Protection