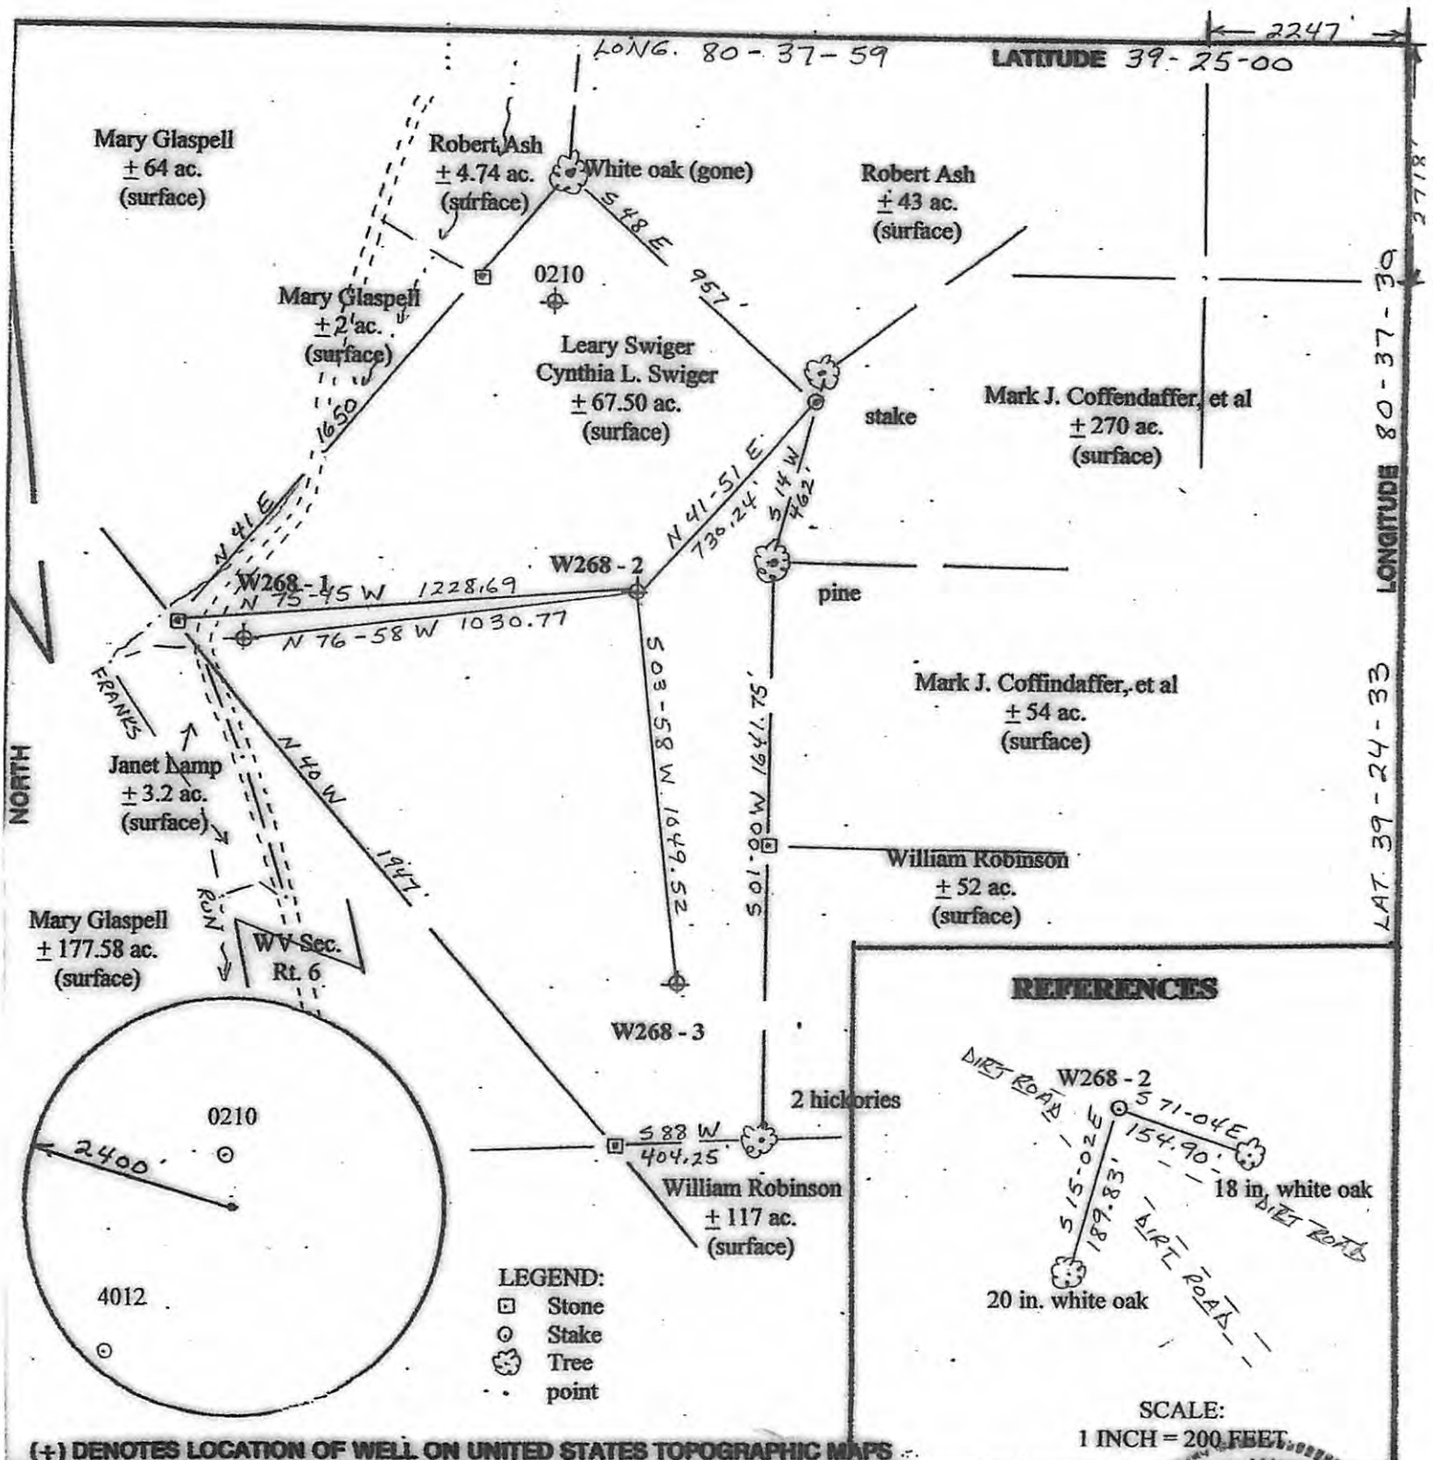

(+) DENOTES LOCATION OF WELL ON UNITED STATES TOPOGRAPHIC MAPS

FILE NO.
DRAWING NO. W268-2
SCALE 1 IN. = 500 FT.
MINIMUM DEGREE OF ACCURACY 1/2500
PROVEN SOURCE OF ELEVATION DGPS

I THE UNDERSIGNED, HEREBY CERTIFY THAT THIS PLAT IS CORRECT TO THE BEST OF MY KNOWLEDGE AND BELIEF AND SHOWS ALL THE INFORMATION REQUIRED BY LAW AND THE REGULATIONS ISSUED AND PRESCRIBED BY THE DEPARTMENT OF ENERGY.

(SIGNED) Daniel J. Wellings 08/14/07

R.P.E. L.L.S. # 1851

DANIEL J. WELLINGS LICENSED No 1851 STATE OF WEST VIRGINIA PROFESSIONAL SURVEYOR

PLACE SEAL HERE

STATE OF WEST VIRGINIA
DIVISION OF ENVIRONMENTAL PROTECTION
OFFICE OF OIL AND GAS

DATE , 19
OPERATOR'S WELL NO. W268-2
API WELL NO.
47 - 017 - 05488
STATE COUNTY PERMIT

CANCELLED

WELL TYPE: OIL X GAS X LIQUID INJECTION WASTE DISPOSAL
(IF "GAS,") PRODUCTION STORAGE DEEP X SHALLOW
LOCATION: ELEVATION 1252 WATER SHED FRANK'S RUN
DISTRICT McCLELLAN COUNTY Lo BARIDGE
QUADRANGLE CENTER POINT 7.5'
SURFACE OWNER LEARY SWIGER & CYNTHIA L. SWIGER ACREAGE 67.5
OIL & GAS ROYALTY OWNER REFER TO APPLICATION LEASE ACREAGE 67.5
LEASE NO.
PROPOSED WORK: DRILL X CONVERT DRILL DEEPER REDRILL FRACTURE OR STIMULATE X PLUG OFF OLD FORMATION PERFORATE NEW FORMATION OTHER PHYSICAL CHANGE IN WELL (SPECIFY)

PLUG AND ABANDON CLEAN OUT AND REPLUG

TARGET FORMATION DEVONIAN SHALE ESTIMATED DEPTH 5990
WELL OPERATOR JAY BEE OIL & GAS, INC. DESIGNATED AGENT RANDY BRODA
ADDRESS 1720 RT. 22 EAST, UNION, NJ 07083 ADDRESS RT. 1 BOX 5, CAIRO, WV 26337

COUNTY NAME
PERMIT

08/09/2013