

1705814P

WW-7
8-30-06



West Virginia Department of Environmental Protection
Office of Oil and Gas

WELL LOCATION FORM: GPS

API: 47-017-05814 WELL NO.: Powell 7
FARM NAME: Powell, Dennis & Mellie
RESPONSIBLE PARTY NAME: Antero Resources Corporation
COUNTY: Doddridge DISTRICT: Grant
QUADRANGLE: Smithburg
SURFACE OWNER: Dennis & Mellie M Powell
ROYALTY OWNER: Dennis & Mellie M Powell
UTM GPS NORTHING: 4347789.68 m
UTM GPS EASTING: 526726.11 m GPS ELEVATION: 247.07 m (810.4')

The Responsible Party named above has chosen to submit GPS coordinates in lieu of preparing a new well location plat for a plugging permit or assigned API number on the above well. The Office of Oil and Gas will not accept GPS coordinates that do not meet the following requirements:

- 1. Datum: NAD 1983, Zone: 17 North, Coordinate Units: meters, Altitude: height above mean sea level (MSL) – meters.
- 2. Accuracy to Datum – 3.05 meters
- 3. Data Collection Method:

Survey grade GPS : Post Processed Differential _____
Real-Time Differential

Mapping Grade GPS : Post Processed Differential _____
Real-Time Differential

RECEIVED
Office of Oil and Gas

NOV 23 2017


WV Department of
Environmental Protection

4. Letter size copy of the topography map showing the well location.

I the undersigned, hereby certify this data is correct to the best of my knowledge and belief and shows all the information required by law and the regulations issued and prescribed by the Office of Oil and Gas.

Matt [Signature] Permitting Supervisor 11/27/17
Signature Title Date

12/01/2017

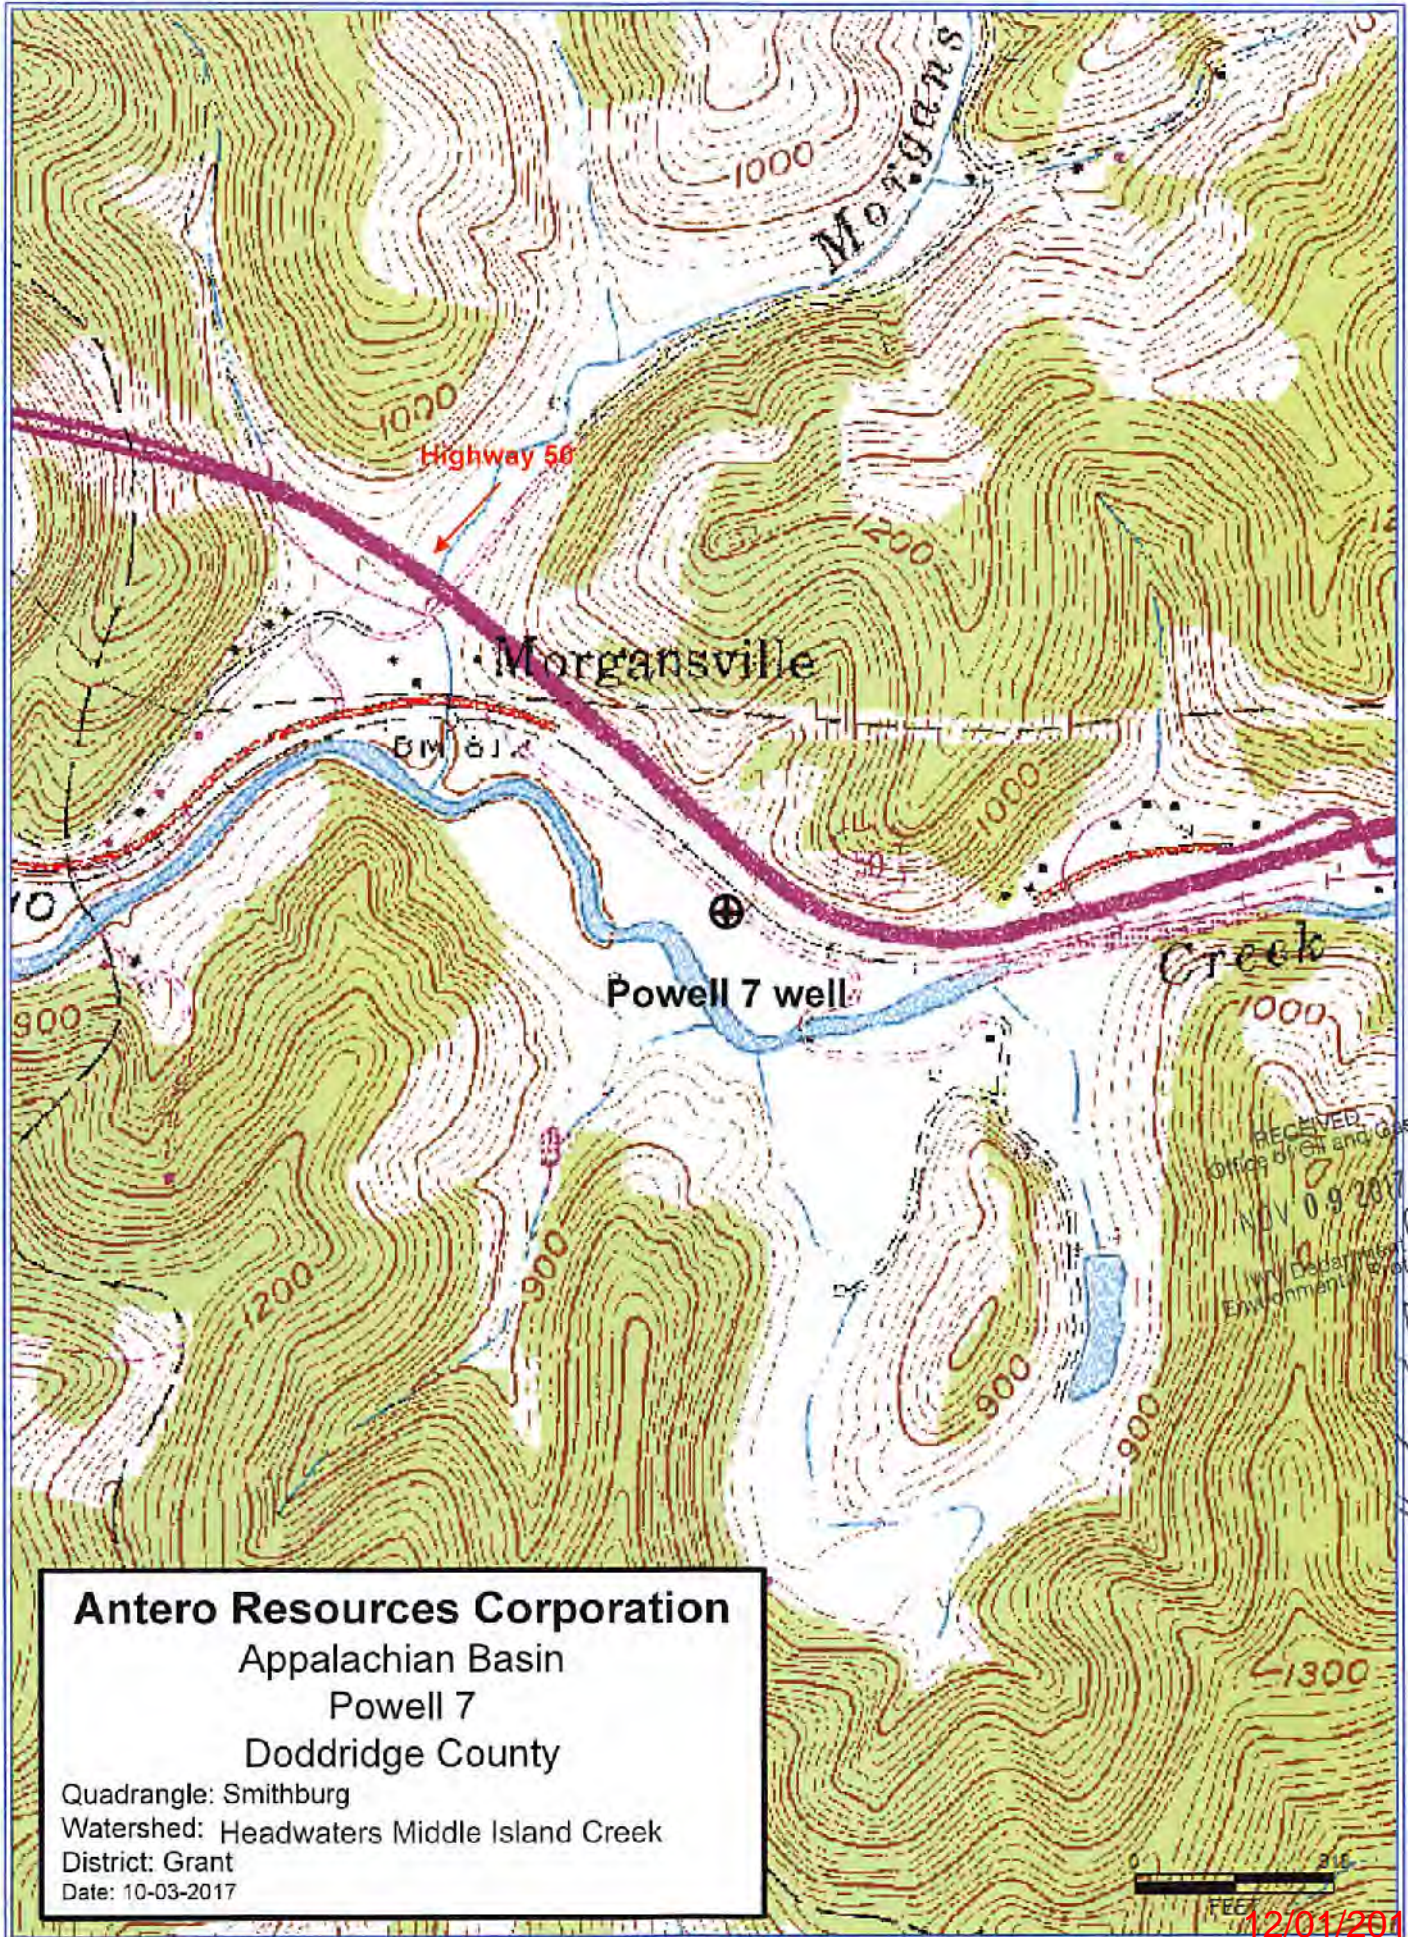

Antero Resources Corporation
 Appalachian Basin
 Powell 7
 Doddridge County

Quadrangle: Smithburg
 Watershed: Headwaters Middle Island Creek
 District: Grant
 Date: 10-03-2017

RECEIVED
 Office of Oil and Gas
 NOV 09 2017
 WV Department of
 Environmental Protection

Handwritten signature
 10/28/17

12/01/2017