


Antero Resources Well No. Irons Unit 2H As-Drilled Plat Antero Resources Corporation

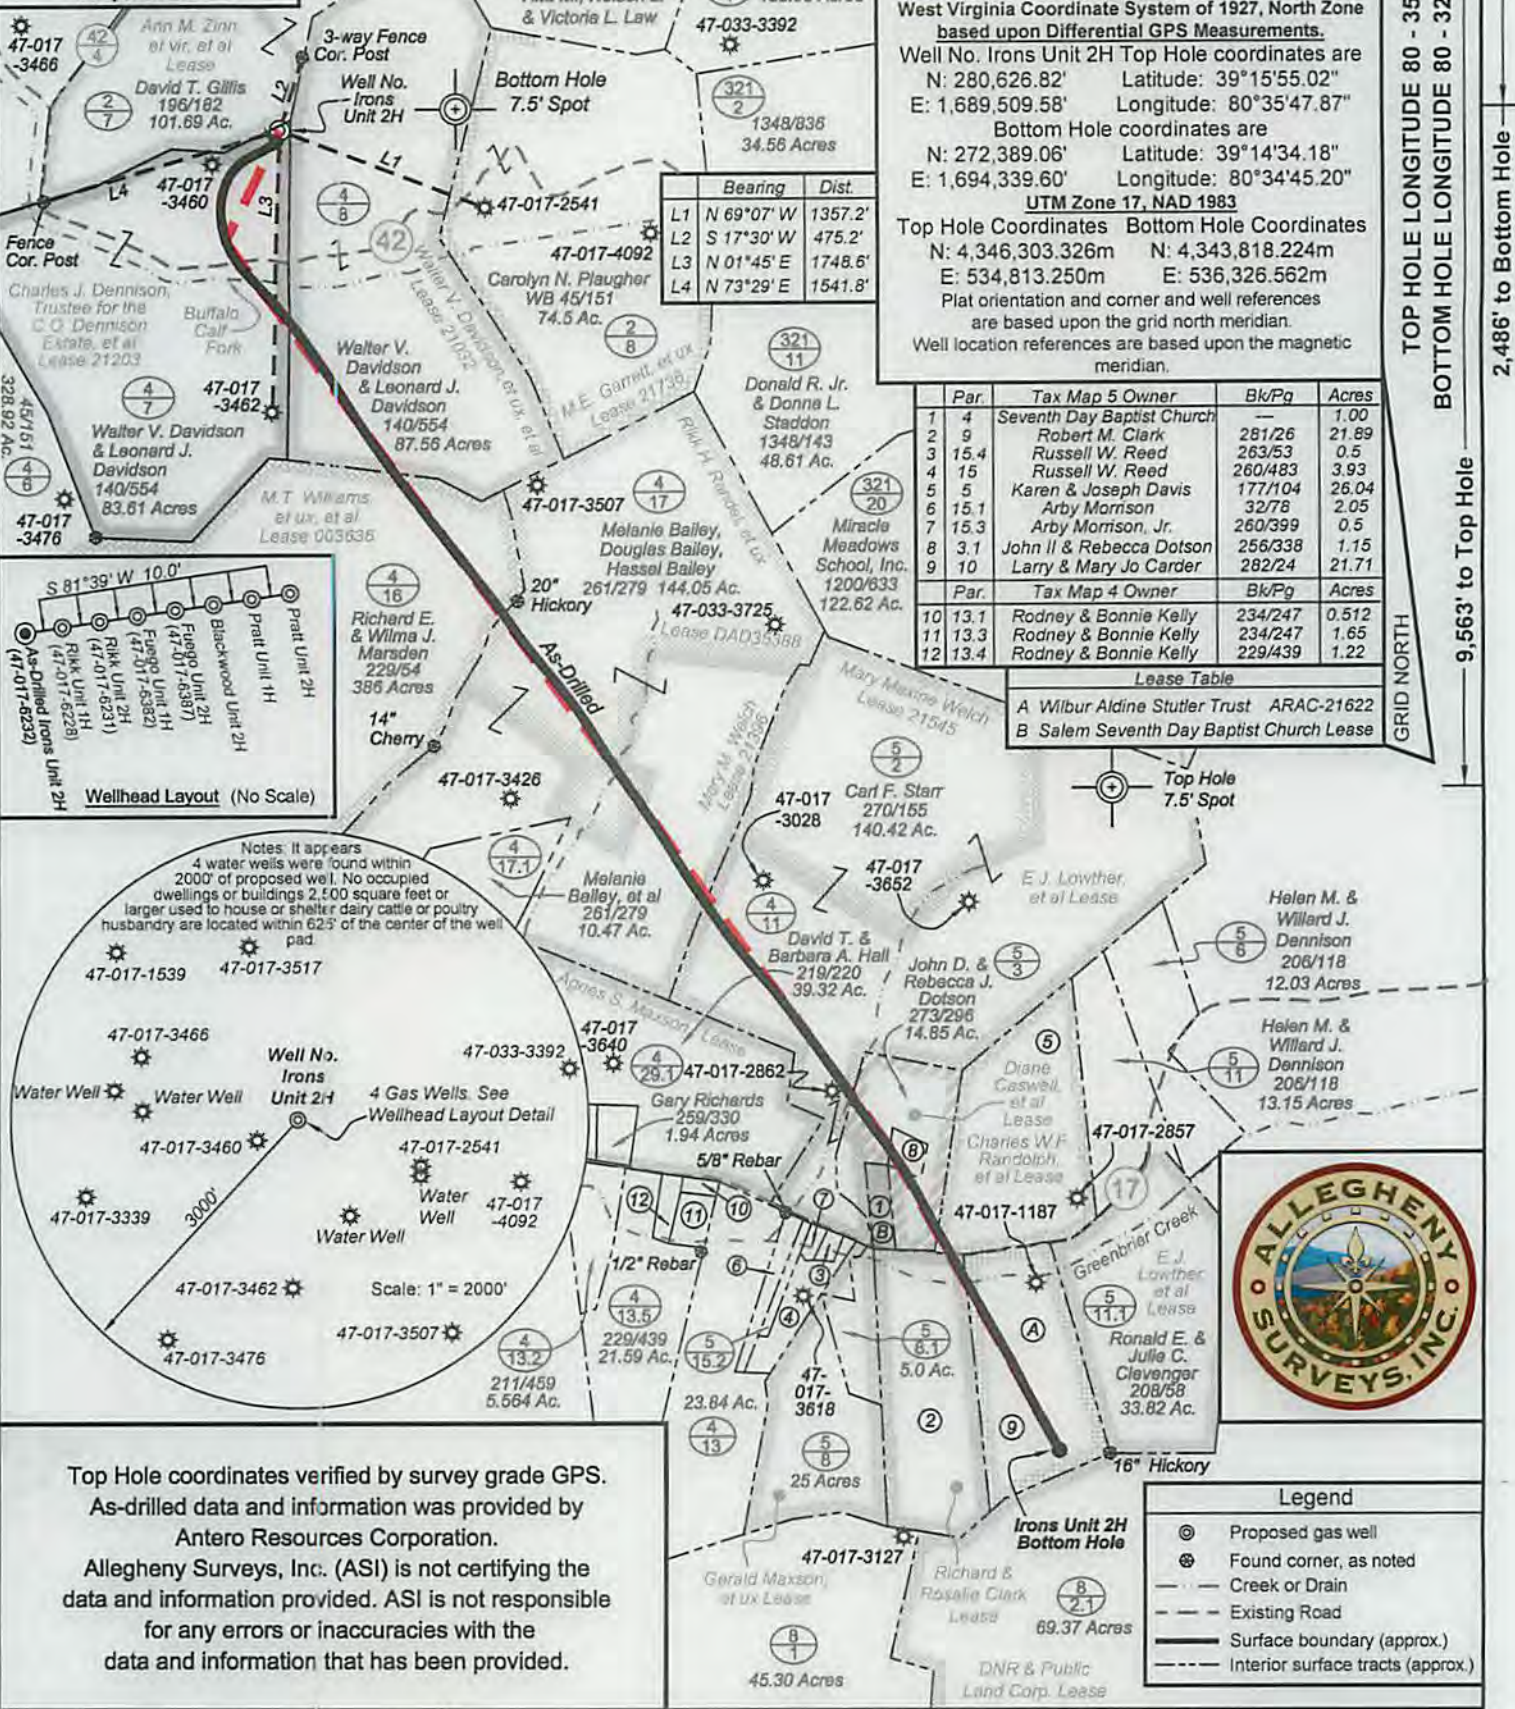

FILE NO: 44-30-GR-13
DRAWING NO: Irons 2H Well Plat As-Drilled
SCALE: 1" = 1200'
MINIMUM DEGREE OF ACCURACY: Submeter
PROVEN SOURCE OF ELEVATION: WVDOT, Bridgeport, WV

STATE OF WEST VIRGINIA
DEPARTMENT OF ENVIRONMENTAL PROTECTION
OIL AND GAS DIVISION

DATE: March 3 2015
OPERATOR'S WELL NO. Irons Unit 2H
API WELL NO
47 - 017 - 06232
STATE COUNTY PERMIT

WELL TYPE: OIL GAS LIQUID INJECTION WASTE DISPOSAL
(IF GAS) PRODUCTION: STORAGE DEEP SHALLOW
LOCATION: ELEVATION: 1320' WATERSHED: Headwaters Middle Island Creek QUADRANGLE: Salem & Big Isaac
DISTRICT: Greenbrier SURFACE OWNER: Walter V. Davidson & Leonard J. Davidson COUNTY: Doddridge
ROYALTY OWNER: Charles J. Dennison, Trustee for the C.O. Dennison Estate, et al LEASE NO: 003636; DAD35388 ACREAGE: 84; 87; 350; 27; 65
PROPOSED WORK: DRILL CONVERT DRILL DEEPER FRACTURE OR STIMULATE PLUG OFF OLD FORMATION
 PERFORATE NEW FORMATION OTHER PHYSICAL CHANGE IN WELL (SPECIFY) As-Drilled 7,421' TVD
 PLUG AND ABANDON CLEAN OUT AND REPLUG TARGET FORMATION: Marcellus Shale DEPTH: 17,014' MD

WELL OPERATOR: Antero Resources Corporation DESIGNATED AGENT: Dianna Stamper - CT Corporation System
ADDRESS: 1615 Wynkoop Street ADDRESS: 5400 D Big Tyler Road
Denver, CO 80202 Charleston, WV 25313



10/30/2015