



west virginia department of environmental protection

Office of Oil and Gas
601 57th Street SE
Charleston, WV 25304
(304) 926-0450
(304) 926-0452 fax

Earl Ray Tomblin, Governor
Randy C. Huffman, Cabinet Secretary
www.dep.wv.gov

PERMIT MODIFICATION APPROVAL

February 21, 2014

EQT PRODUCTION COMPANY
POST OFFICE BOX 280
BRIDGEPORT, WV 26330

Re: Permit Modification Approval for API Number 1706252 , Well #: 514320

Changed Azimuth and Formation

Oil and Gas Operator:

The Office of Oil and Gas has reviewed the attached permit modification for the above referenced permit. The attached modification has been approved and well work may begin. Please be reminded that the oil and gas inspector is to be notified twenty-four (24) hours before permitted well work is commenced.

Please call James Martin at 304-926-0499, extension 1654 if you have any questions.

Sincerely,

for
Gene Smith
Regulatory/Compliance Manager
Office of Oil and Gas



October 24, 2013

Mr. Gene Smith
West Virginia Department of Environmental Protection
Office of Oil and Gas
601 57th Street SE
Charleston, WV 25304

Re: Modification of 47-103-06252 (514320)

Dear Mr. Smith,

Attached is a modification to the above well. The well is being modified from a Marcellus well to a Genessee with a change in the azimuth. The top hole has NOT changed from the original permit and no new leases were affected. I am enclosing a new WW-6B, well schematics and a mylar plat.

If you have any questions, please do not hesitate to contact me at (304) 848-0076.

Sincerely,

Vicki Roark
Permitting Supervisor-WV

Enc.

cc: Derek Haught
P.O. Box 85
Smithville, WV 26178

RECEIVED
Office of Oil and Gas
OCT 28 2013
WV Department of
Environmental Protection

RECEIVED
Office of Oil and Gas

MOD

STATE OF WEST VIRGINIA
DEPARTMENT OF ENVIRONMENTAL PROTECTION, OFFICE OF OIL AND GAS
W.VA. CODE §22-6A - WELL WORK PERMIT APPLICATION

Well Operator: EQT Production Company
Operator ID: 103 County: 4 District: 286 Quadrangle

Operator's Well Number: 514320 Well Pad Name: CPT11

Farm Name/Surface Owner: Flint Run of McElroy Creek Public Road Access: CR 12

Elevation, current ground: 1,130.0 Elevation, proposed post-construction: 1,111.0

Well Type: (a) Gas Oil Underground Storage
Other _____

(b) If Gas: Shallow Deep
Horizontal

Existing Pad? Yes or No: Yes

Proposed Target Formation(s), Depth(s), Anticipated Thicknesses and Associated Pressure(s):
Target formation is Geneseeo at a depth of 6843' with the anticipated thickness to be 46 feet and anticipated target pressure of 4691 PSI

- Proposed Total Vertical Depth: 6,843
- Formation at Total Vertical Depth: Geneseeo
- Proposed Total Measured Depth: 15,332
- Proposed Horizontal Leg Length: 6,660
- Approximate Fresh Water Strata Depths: 66, 337, 386, 406, 616, 704
- Method to Determine Fresh Water Depth: By offset wells
- Approximate Saltwater Depths: 1389, 1661
- Approximate Coal Seam Depths: 852, 1264
- Approximate Depth to Possible Void (coal mine, karst, other): None reported

Does proposed well location contain coal seams directly overlying or adjacent to an active mine?

(a) If Yes, provide Mine Info: Name: _____
Depth: _____
Seam: _____
Owner: _____

DCW
11-4-2013
MAG

RECEIVED
Office of Oil and Gas

02/28/2014

NOV 13 2013

WV Department of
Environmental Protection

CASING AND TUBING PROGRAM

3)

TYPE	Size	New or Used	Grade	Weight per ft.	FOOTAGE: for Drilling	INTERVALS: Left in Well	CEMENT: Fill-up (Cu.Ft.)
Conductor	20	New	Varies	Varies	40	40	38
Fresh Water	13 3/8	New	MC-50	54	804	804	705
Isolation					5,242	5,242	2,066
Intermediate	9 5/8	New	MC-50	40			
Production	5 1/2	New	P-110	20	15,332	15,332	See Note 1
Tubing	2 3/8		J-55	4.6			May not be run, if run will be set 100' less than TD
Packers							

CTS
CTS
Doug Newton
11-4-2013
Michael [Signature]

TYPE	Size	Wellbore Diameter	Wall Thickness	Burst Pressure	Cement Type	Cement Yield (cu. ft./k)
Conductor	20	24	0.635	-	Construction	1.18
Fresh Water	13 3/8	17 1/2	0.380	2,480	1	1.21
Isolation						
Intermediate	9 5/8	12 3/8	0.395	3,590	1	1.21
Production	5 1/2	8 1/2	0.361	12,640	-	1.27/1.86
Tubing						
Packers						

Packers

Kind:	N/A		
Sizes:	N/A		
Depths Set:	N/A		

Note 1: EQT plans to bring the TOC on the production casing cement job 1,000' above kick off point, which is at least 500' above the shallowest production zone, to avoid communication.

RECEIVED
Office of Oil and Gas

NOV 13 2013 02/28/2014

Department of
Environmental Protection

19) Describe proposed well work, including the drilling and plugging back of any pilot hole:

Drill and complete a new horizontal well in the Genesee formation. The vertical drill to go down to an approximate depth of 5868'.
Then kick off the horizontal leg into the Genesee using a slick water frac.

20) Describe fracturing/stimulating methods in detail, including anticipated max pressure and max rate:

Hydraulic fracturing is completed in accordance with state regulations using water recycled from previously fractured wells and obtained from freshwater sources. This water is mixed with sand and a small percentage (less than 0.3%) of chemicals (including 15% Hydrochloric acid, gelling agent, gel breaker, friction reducer, biocide, and scale inhibitor), referred to in the industry as a "slickwater" completion. Maximum anticipated treating pressures are expected to average approximately 8500 psi, maximum anticipated treating rates are expected to average approximately 100 bpm. Stage lengths vary from 150 to 300 feet. Average approximately 200,000 barrels of water per stage. Sand sizes vary from 100 mesh to 20/40 mesh. Average approximately 200,000 pounds of sand per stage.

21) Total area to be disturbed, including roads, stockpile area, pits, etc, (acres): 43.82

22) Area to be disturbed for well pad only, less access road (acres): 15.68

23) Describe centralizer placement for each casing string.

- Surface: Bow spring centralizers – One at the shoe and one spaced every 500'.
- Intermediate: Bow spring centralizers– One cent at the shoe and one spaced every 500'.
- Production: One spaced every 1000' from KOP to Int csg shoe

24) Describe all cement additives associated with each cement type. **Surface (Type 1 Cement):** 0-3% Calcium Chloride

Used to speed the setting of cement slurries.

0.4% flake. Loss Circulation Material (LCM) is used to combat the loss of the cement slurry to a thief zone.

Intermediate (Type 1 Cement): 0-3% Calcium Chloride. Salt is used in shallow, low temperature formations to speed the setting of cement slurries. 0.4% flake. Loss Circulation Material (LCM) is used to combat the loss of whole drilling fluid or cement slurry (not filtrate) to a thief zone.

Production:

Lead (Type 1 Cement): 0.2-0.7% Lignosulfonate (Retarder). Lengthens thickening time.

0.3% CFR (dispersant). Makes cement easier to mix.

Tail (Type H Cement): 0.25-0.40% Lignosulfonate (Retarder). Lengthens thickening time.

0.2-0.3% CFR (dispersant). This is to make the cement easier to mix.

60 % Calcium Carbonate. Acid solubility.

0.4-0.6% Halad (fluid loss). Reduces amount of water lost to formation.

25) Proposed borehole conditioning procedures. **Surface:** Circulate hole clean (Approximately 30-45 minutes) rotating & reciprocating

one full joint until cuttings diminish at surface. When cuttings returning to surface diminish, continue to circulate an additional 5 minutes. To ensure that there is no fill, short trip two stands with no circulation. If there is fill, bring compressors back on and circulate hole clean. A constant rate of higher than expected cuttings volume likely indicates washouts that will not clean up.

Intermediate: Circulate hole clean (Approximately 30-45 minutes) rotating & reciprocating one full joint until cuttings diminish at surface. When cuttings returning to surface diminish, continue to circulate an additional 5 minutes. If foam drilling, to enhance hole cleaning use a soap sweep or increase injection rate & foam concentration.

Production: Pump marker sweep with nut plug to determine actual hole washout. Calculate a gauge holes bottoms up volume.

Perform a cleanup cycle by pumping 3-5 bottoms up or until the shakers are clean. Check volume of cuttings coming across the shakers every 15 minutes.

*Note: Attach additional sheets as needed.

RECEIVED
Office of Oil and Gas
02/28/2014

OCT 28 2013

WV Department of
Environmental Protection

MOD

017 06252

Well 514320 (CPT11HS)
 EOT Production
 Center Point
 Doddridge West Virginia

Admuth 185.87
 Vertical Section 7.85T

TVD Depth (feet)	Formation	Formation Tops (TVD)	Admuth	Vertical Section	Hole Size (inches)	Casing Type	Casing Size (inches)	WT (ppf)/Grade
250'			185.87	7.85T	24	Conductor	20	
500'								
750'	Base Fresh Water	704						
1,000'	Base Red Rock	1097			17 1/2	Surface	13 3/8	54#/MC-50
1,250'								
1,500'								
1,750'								
2,000'	Maxton Big Lime	1950 2120	2032					
2,250'	Big Injun Wet	2216 2487	2216 2552	(2000)				
2,500'	Gantz Flyfoot	2619 2668	2674 2723					
2,750'	Truety foot Garden	2825 2912	2850 2976					
3,000'	Fork Sand Fork Sand	2975 3024	3074 3151	(3000)				
3,250'								
3,500'	Warren	3559	3606					
3,750'	Speechley Baltimore A	3757 3987	3956 4410					
4,000'								
4,250'	Stadard	4220	4342					
4,500'								
4,750'								
5,000'	Barton Int. csg pt	5123 5242	5192		12 3/8	Intermediate	9 5/8	40#/MC-50
5,250'	Alexander Elix	5245 5565	5525 5583					
5,500'								
5,750'								
6,000'								
6,250'	Sonyea Middlesex	6503 6725	6677 6761					
6,500'	Genesee Genesee Top	6751 6843	6843		8 1/2	Production Casing	5 1/2	20#/P-110
6,750'	Target Inside Genesee Genesee Bottom	6871	6871					
7,000'								

Proposed Well Work:
 Drill and complete a new horizontal well in the Genesee formation.
 The vertical drill to go down to an approximate depth of 5868'.
 Then kick of the horizontal leg into the Genesee using a slick water frac.



RECEIVED
 Office of Oil and Gas
 02/28/2014
 OCT 28 2013
 WV Department of
 Environmental Protection


MOD

017 06252

Well Schematic
EQT Production

Well Name: 514320 (CPT11H5)
County: Doddridge
State: West Virginia

Elevation KB: 1121
Target: Genesee
Prospect: 165.87
Azimuth: 7467
Vertical Section:

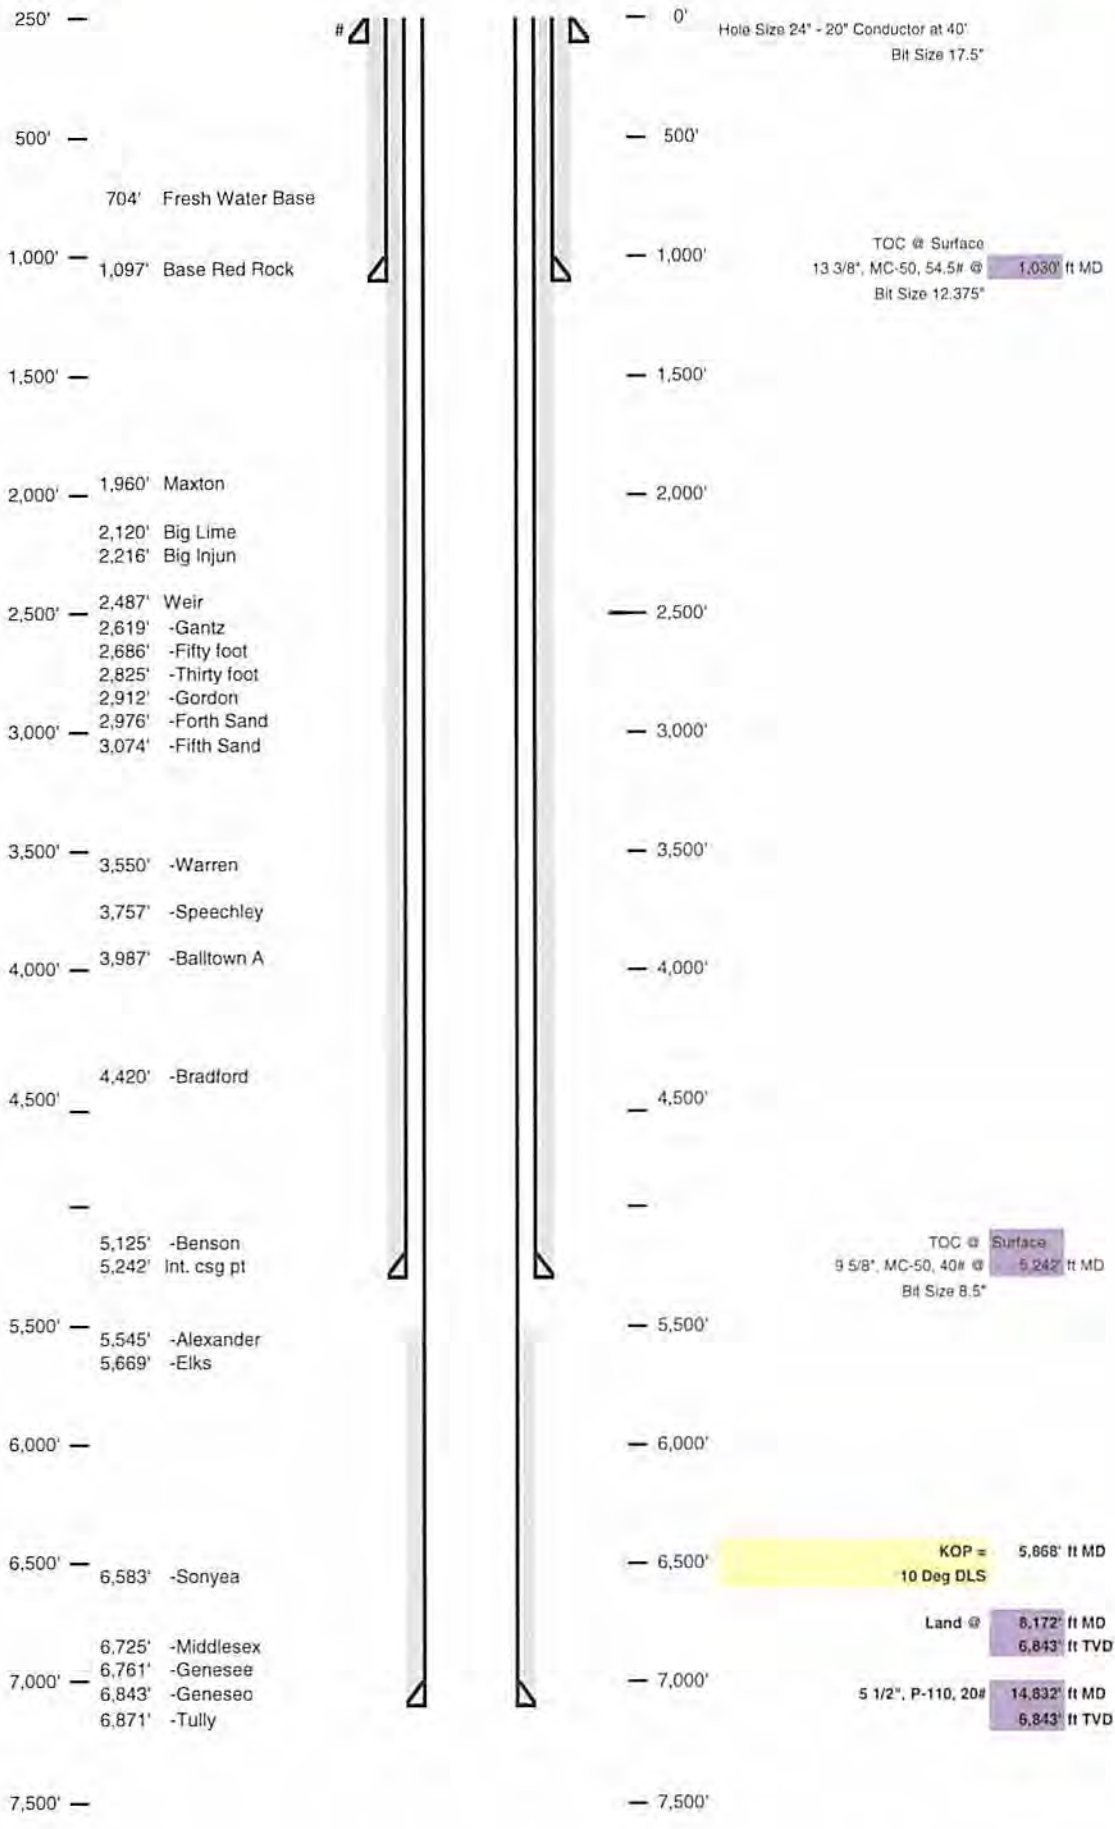

JMD 41.452

RECEIVED
Office of Oil and Gas
OCT 28 2013 02/28/2014
WV Department of
Environmental Protection

EQT PRODUCTION COMPANY J.D. McREYNOLDS LEASE 1500± ACRES WELL NO. WV 514320

WELL NO. WV 514320
STATE PLANE COORDINATES
NORTH ZONE (NAD 27)
N. 324,473.2
E. 1,654,133.6

LAT=(N) 39.384404
LONG=(W) 80.723670
UTM (NAD'83)(METERS)
N. 4,359,481.3
E. 523,813.0

LANDING POINT
WELL NO. WV 514320
STATE PLANE COORDINATES
NORTH ZONE (NAD 27)
N. 323,469.2
E. 1,652,762.3

LAT=(N) 39.381596
LONG=(W) 80.728472
UTM (NAD'83)(METERS)
N. 4,359,168.5
E. 523,400.3

BOTTOM HOLE
WELL NO. WV 514320
STATE PLANE COORDINATES
NORTH ZONE (NAD 27)
N. 317,010.7
E. 1,654,388.2

LAT=(N) 39.363926
LONG=(W) 80.722410
UTM (NAD'83)(METERS)
N. 4,357,209.1
E. 523,928.5



RESEARCH INDICATES THAT CO. RT. 3 IN THIS AREA MAY BE PART OF OLD TURNPIKE SYSTEM. TYPICALLY A 60 FOOT WIDE STRIP OF LAND CLAIMED IN FEE BY WVDOH

A	TRUSTEES OF CHESTNUT GROVE CHURCH	28.25 AC±
B	STEPHEN W & REMONDA L TRENT	11.88 AC±
C	TRUSTEES OF CHESTNUT GROVE CHURCH	65.16 AC±

REFERENCES

- H5 (47-017-06252)
- H4 (47-017-06251)
- H3 (47-017-06250)
- H2 (47-017-06249)
- H1 (47-017-06248)

- NOTES ON SURVEY**
1. TIES TO WELLS, CORNERS, AND REFERENCES ARE BASED ON GRID NORTH FOR THE WV STATE PLANE COORDINATE SYSTEM NORTH ZONE NAD '27.
 2. LEASE BOUNDARY SHOWN HEREON TAKEN FROM DEED BOOK 280 PAGE 695, DEED BOOK 223 PAGE 430, DEED BOOK 282 PAGE 406 & DEED BOOK 175 PAGE 633.
 3. SURFACE OWNER AND ADJOINER INFORMATION TAKEN FROM THE ASSESSOR AND COUNTY CLERK RECORDS OF DODDRIDGE COUNTY IN JULY, 2013.
 4. WELL LAT./LONG. (NAD'27) ESTABLISHED BY DGPS (SURVEY GRADE TIE TO CORS NETWORK).
 5. NO WATER WELLS WERE FOUND WITHIN 250 FEET OF PROPOSED GAS WELL. NO AGRICULTURAL BUILDINGS (GREATER THAN 2500 SQUARE FEET) OR DWELLINGS WERE FOUND WITHIN 625 FEET OF CENTER OF PROPOSED WELL PAD.



I THE UNDERSIGNED, HEREBY CERTIFY THAT THIS PLAT IS CORRECT TO THE BEST OF MY KNOWLEDGE AND BELIEF AND SHOWS ALL THE INFORMATION REQUIRED BY LAW AND THE REGULATIONS ISSUED AND PRESCRIBED BY THE DIVISION OF ENVIRONMENTAL PROTECTION.

P.S. 677 *Gregory A. Smith*



(+) DENOTES LOCATION OF WELL ON UNITED STATES TOPOGRAPHIC MAPS.

DATE MARCH 15 20 13

REVISED DATE OCTOBER 17 20 13

OPERATORS WELL NO. WV 514320

API WELL NO. 47-017-06252 MOD H6A

STATE COUNTY PERMIT

MINIMUM DEGREE OF ACCURACY 1/200 FILE NO. 7749P514320R

PROVEN SOURCE OF ELEVATION DGPS (SURVEY GRADE TIE TO CORS NETWORK) SCALE 1" = 2000'

STATE OF WEST VIRGINIA
DIVISION OF ENVIRONMENTAL PROTECTION
OFFICE OF OIL AND GAS



WELL TYPE: OIL GAS LIQUID INJECTION WASTE DISPOSAL IF "GAS" PRODUCTION STORAGE DEEP SHALLOW

LOCATION: ELEVATION 1,130' (GROUND) 1,111 (PROPOSED) WATERSHED FLINT RUN OF McELROY CREEK

DISTRICT GRANT COUNTY DODDRIDGE QUADRANGLE CENTER POINT 7.5'

SURFACE OWNER JORDAN FAMILY PARTNERSHIP ACREAGE 460±

ROYALTY OWNER J. D. McREYNOLDS HEIRS/ASSIGNS ACREAGE 1500±

PROPOSED WORK: DRILL CONVERT DRILL DEEPER REDRILL FRACTURE OR STIMULATE PLUG OFF OLD FORMATION PERFORATE NEW FORMATION PLUG AND ABANDON CLEAN OUT AND REPLUG OTHER

PHYSICAL CHANGE IN WELL (SPECIFY) TARGET FORMATION GENESSO ESTIMATED DEPTH TVD 6843

WELL OPERATOR EQT PRODUCTION COMPANY DESIGNATED AGENT REX C. RAY

ADDRESS 115 PROFESSIONAL PLACE P.O. BOX 280 BRIDGEPORT, WV 26330 ADDRESS 115 PROFESSIONAL PLACE P.O. BOX 280 BRIDGEPORT, WV 26330

COUNTY NAME PERMIT

02/28/2014