FORM WW 6

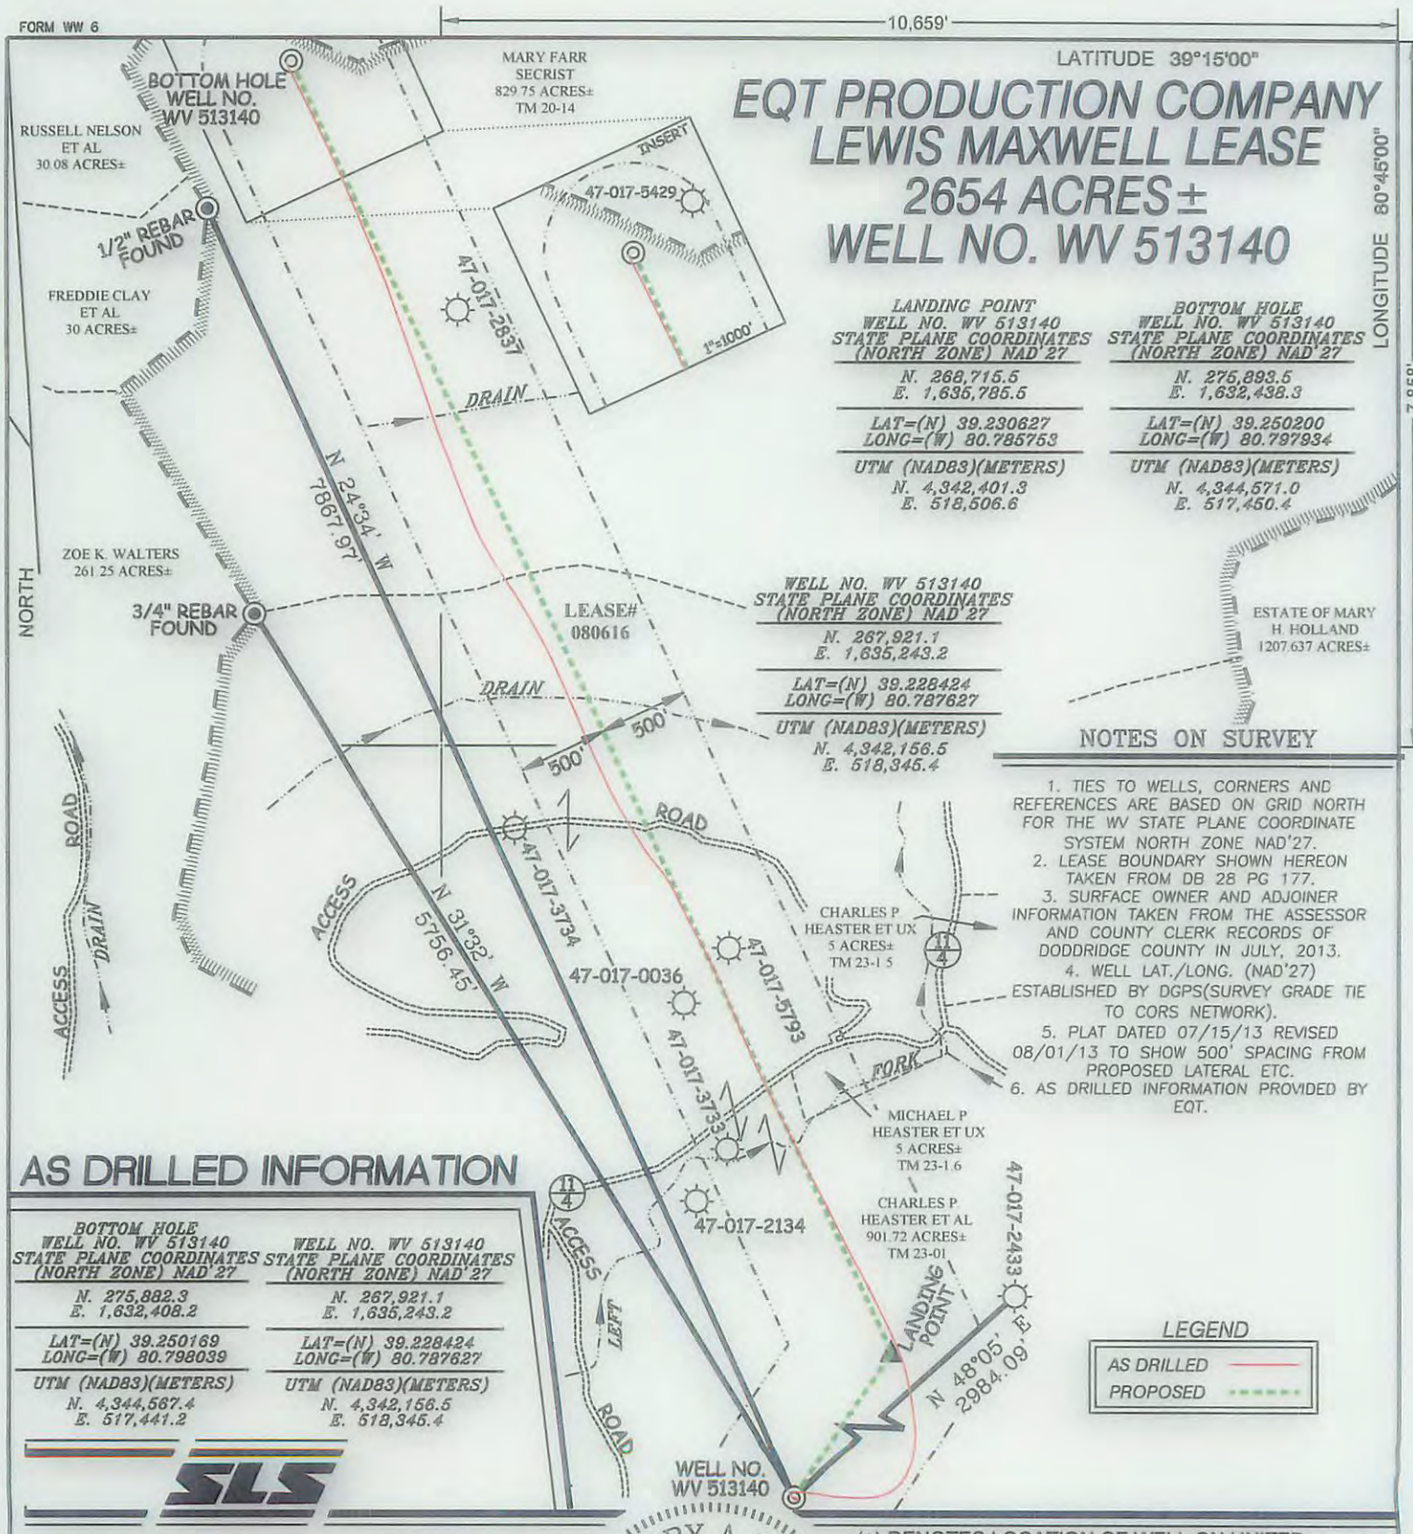

EQT PRODUCTION COMPANY
LEWIS MAXWELL LEASE
2654 ACRES±
WELL NO. WV 513140

LANDING POINT WELL NO. WV 513140 STATE PLANE COORDINATES (NORTH ZONE) NAD'27	BOTTOM HOLE WELL NO. WV 513140 STATE PLANE COORDINATES (NORTH ZONE) NAD'27
N. 268,715.5 E. 1,635,785.5	N. 275,893.5 E. 1,632,438.3
LAT=(N) 39.230627 LONG=(W) 80.785753	LAT=(N) 39.250200 LONG=(W) 80.797934
UTM (NAD83)(METERS) N. 4,342,401.3 E. 518,506.6	UTM (NAD83)(METERS) N. 4,344,571.0 E. 517,450.4

WELL NO. WV 513140 STATE PLANE COORDINATES (NORTH ZONE) NAD'27
N. 267,921.1 E. 1,635,243.2
LAT=(N) 39.228424 LONG=(W) 80.787627
UTM (NAD83)(METERS) N. 4,342,156.5 E. 518,345.4

NOTES ON SURVEY

1. TIES TO WELLS, CORNERS AND REFERENCES ARE BASED ON GRID NORTH FOR THE WV STATE PLANE COORDINATE SYSTEM NORTH ZONE NAD'27.
2. LEASE BOUNDARY SHOWN HEREON TAKEN FROM DB 28 PG 177.
3. SURFACE OWNER AND ADJOINER INFORMATION TAKEN FROM THE ASSESSOR AND COUNTY CLERK RECORDS OF DODDRIDGE COUNTY IN JULY, 2013.
4. WELL LAT./LONG. (NAD'27) ESTABLISHED BY DGPS(SURVEY GRADE TIE TO CORS NETWORK).
5. PLAT DATED 07/15/13 REVISED 08/01/13 TO SHOW 500' SPACING FROM PROPOSED LATERAL ETC.
6. AS DRILLED INFORMATION PROVIDED BY EQT.

AS DRILLED INFORMATION

BOTTOM HOLE WELL NO. WV 513140 STATE PLANE COORDINATES (NORTH ZONE) NAD'27	WELL NO. WV 513140 STATE PLANE COORDINATES (NORTH ZONE) NAD'27
N. 275,882.3 E. 1,632,408.2	N. 267,921.1 E. 1,635,243.2
LAT=(N) 39.250169 LONG=(W) 80.798039	LAT=(N) 39.228424 LONG=(W) 80.787627
UTM (NAD83)(METERS) N. 4,344,567.4 E. 517,441.2	UTM (NAD83)(METERS) N. 4,342,156.5 E. 518,345.4

SLS

LEGEND
AS DRILLED
PROPOSED

I THE UNDERSIGNED, HEREBY CERTIFY THAT THIS PLAT IS CORRECT TO THE BEST OF MY KNOWLEDGE AND BELIEF AND SHOWS ALL THE INFORMATION REQUIRED BY LAW AND THE REGULATIONS ISSUED AND PRESCRIBED BY THE DIVISION OF ENVIRONMENTAL PROTECTION.

P.S. 677 Gregory A. Smith

GREGORY A. SMITH LICENSED No. 677 STATE OF WEST VIRGINIA PROFESSIONAL SURVEYOR

(+) DENOTES LOCATION OF WELL ON UNITED STATES TOPOGRAPHIC MAPS.

DATE AUGUST 1 , 20 13

REVISED DATE AUGUST 27 , 20 14

OPERATORS WELL NO. WV 513140

API WELL NO. 47 — — — (STATE / COUNTY / PERMIT)

MINIMUM DEGREE OF ACCURACY 1 / 200

PROVEN SOURCE OF ELEVATION DGPS (SURVEY GRADE TIE TO CORS NETWORK)

FILE NO. 6980ASDRILLED513140

SCALE 1" = 1000'

STATE OF WEST VIRGINIA
DIVISION OF ENVIRONMENTAL PROTECTION
OFFICE OF OIL AND GAS

WELL TYPE : OIL ____ GAS X LIQUID INJECTION ____ WASTE DISPOSAL ____ IF "GAS" PRODUCTION X STORAGE ____ DEEP ____ SHALLOW X

LOCATION :
ELEVATION 1,244'(GROUND) 1,202'(PROPOSED) WATERSHED LEFT FORK ARNOLDS CREEK
DISTRICT WEST UNION COUNTY DODDRIDGE QUADRANGLE OXFORD 7.5'
SURFACE OWNER CHARLES P. HEASTER ET AL ACREAGE 901.72 ±
ROYALTY OWNER LEWIS MAXWELL HRS ACREAGE 2654 ± 06/12/2015
PROPOSED WORK : LEASE NO. 080616
DRILL X CONVERT ____ DRILL DEEPER ____ REDRILL ____ FRACTURE OR STIMULATE X PLUG OFF OLD FORMATION ____ PERFORATE NEW FORMATION ____ PLUG AND ABANDON ____ CLEAN OUT AND REPLUG ____ OTHER ____
PHYSICAL CHANGE IN WELL (SPECIFY) ____ TARGET FORMATION MARCELLUS
ESTIMATED DEPTH ____

COUNTY NAME

PERMIT

WELL OPERATOR EQT PRODUCTION COMPANY
ADDRESS 115 PROFESSIONAL PLACE P.O. BOX 280
BRIDGEPORT, WV 26330

DESIGNATED AGENT REX C. RAY
ADDRESS 115 PROFESSIONAL PLACE P.O. BOX 280
BRIDGEPORT, WV 26330

SLS
124830